
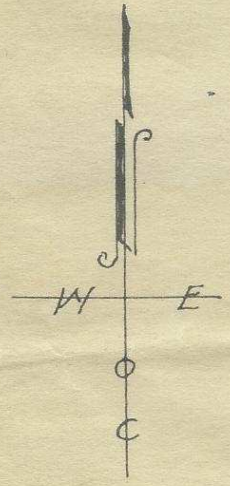


G-141-Ax

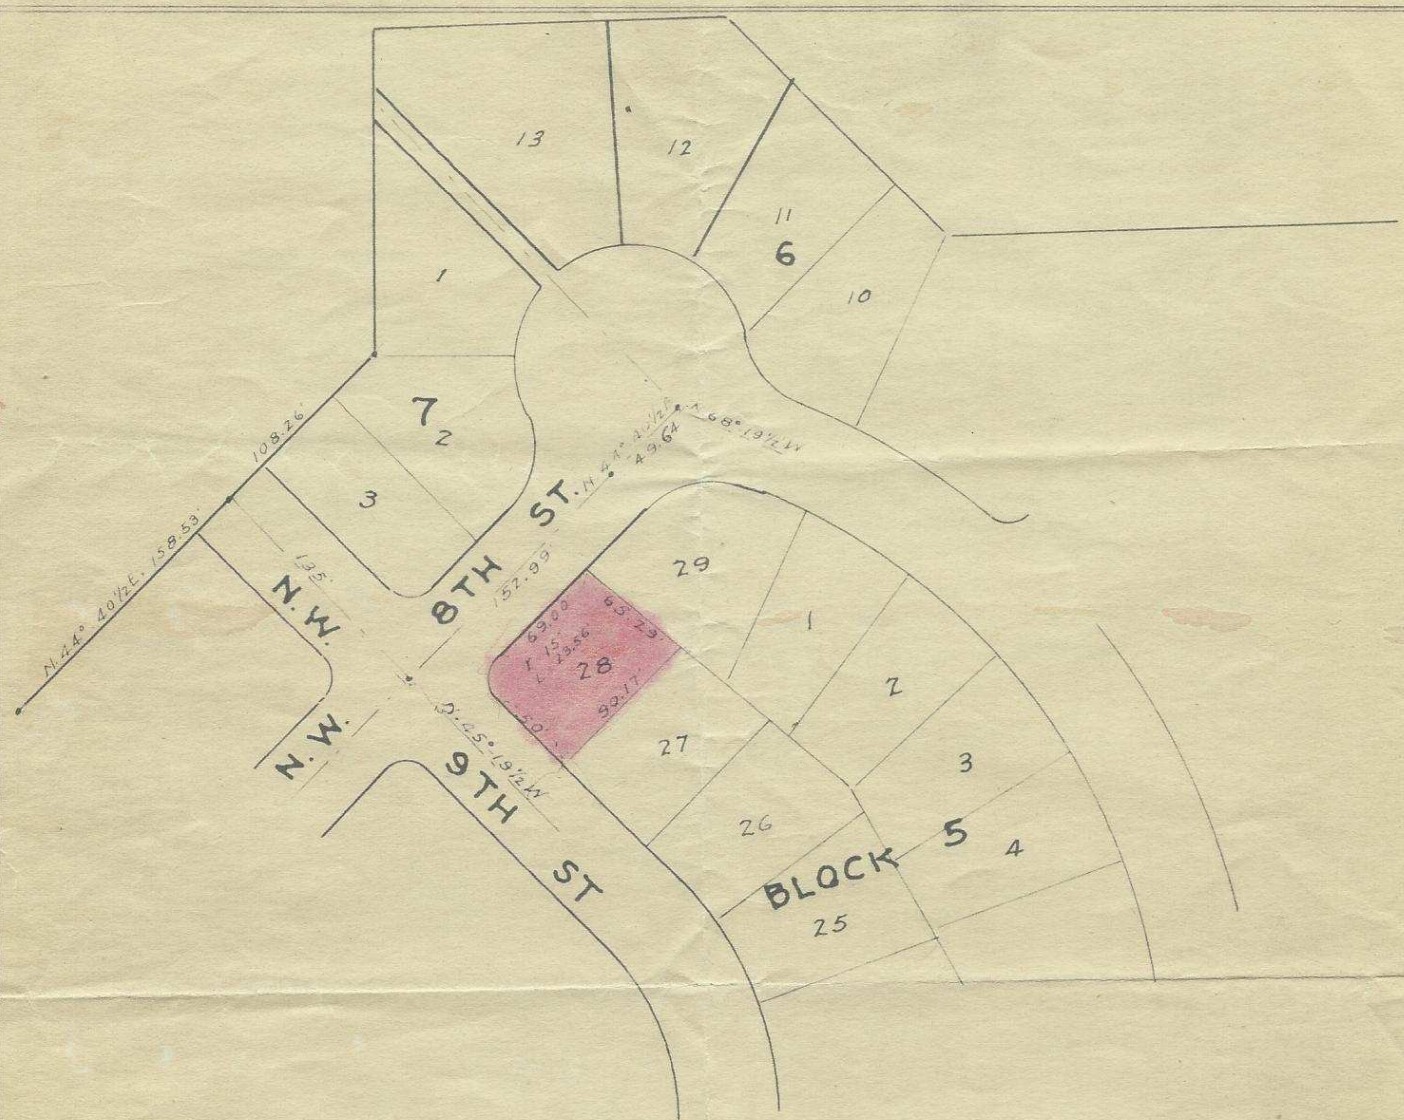

SURVEYED, STAKED AND  
 PLATTED JANUARY 1948  
 BY W.E.O. CRIGER

NW<sup>1</sup> SE<sup>4</sup> (3)  
 PLAT SHOWING  
 LOT 28, BLOCK 5  
 CURRY'S ADDITION  
 TO PENDLETON, ORE.  
 SCALE: 1"=100'

H.H. Cabin =

G-141-Ax 478