


Q-146-AX

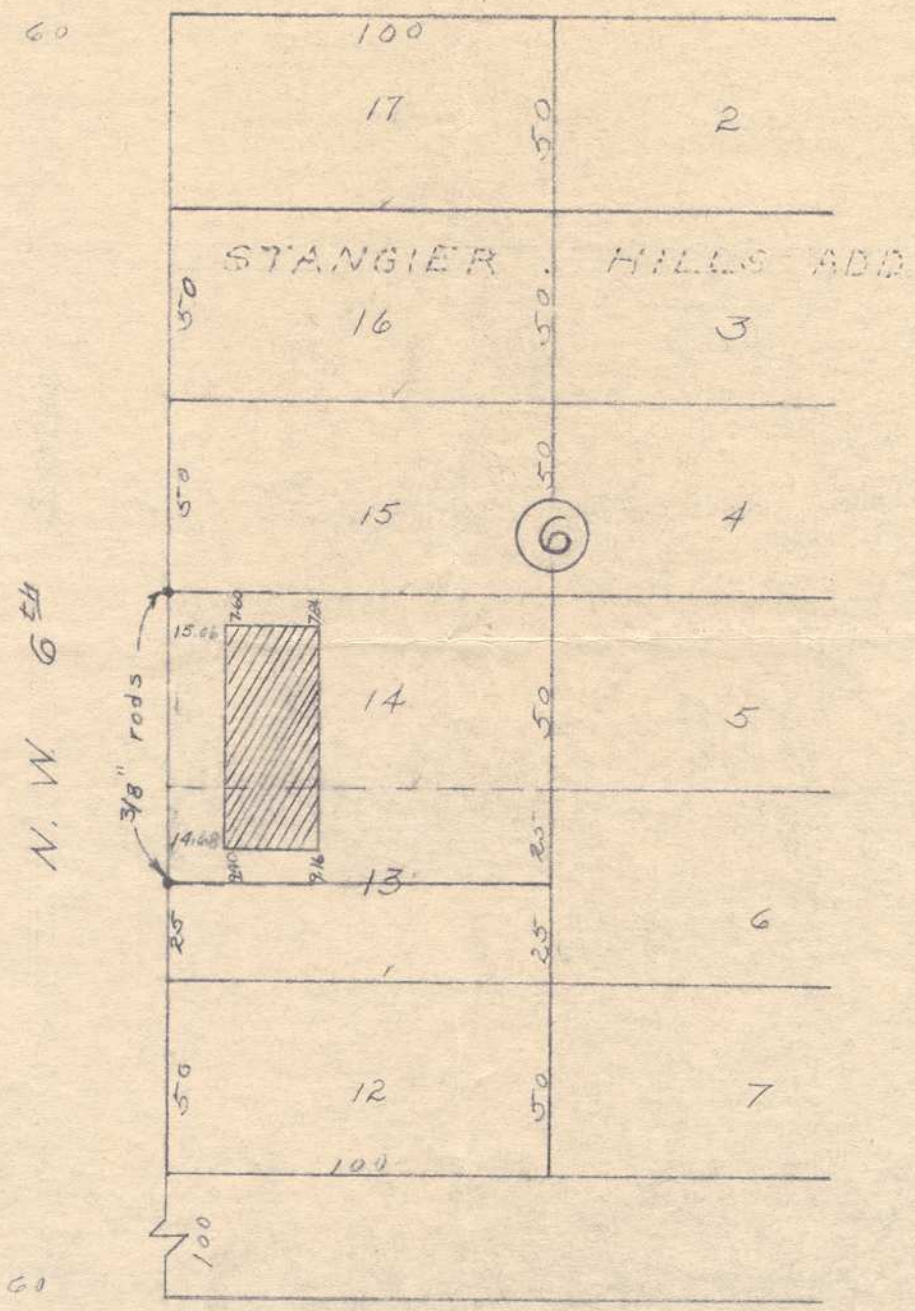

N. W. HORN AVE.

NW 1/4 SE 1/4 (3) DA

SCALE: 1" = 50'	DATE: 4-11-56
WALL AND TENNESON Engineers	
The Dalles	Oregon

Q-146-AX 362