


Q-157-AX

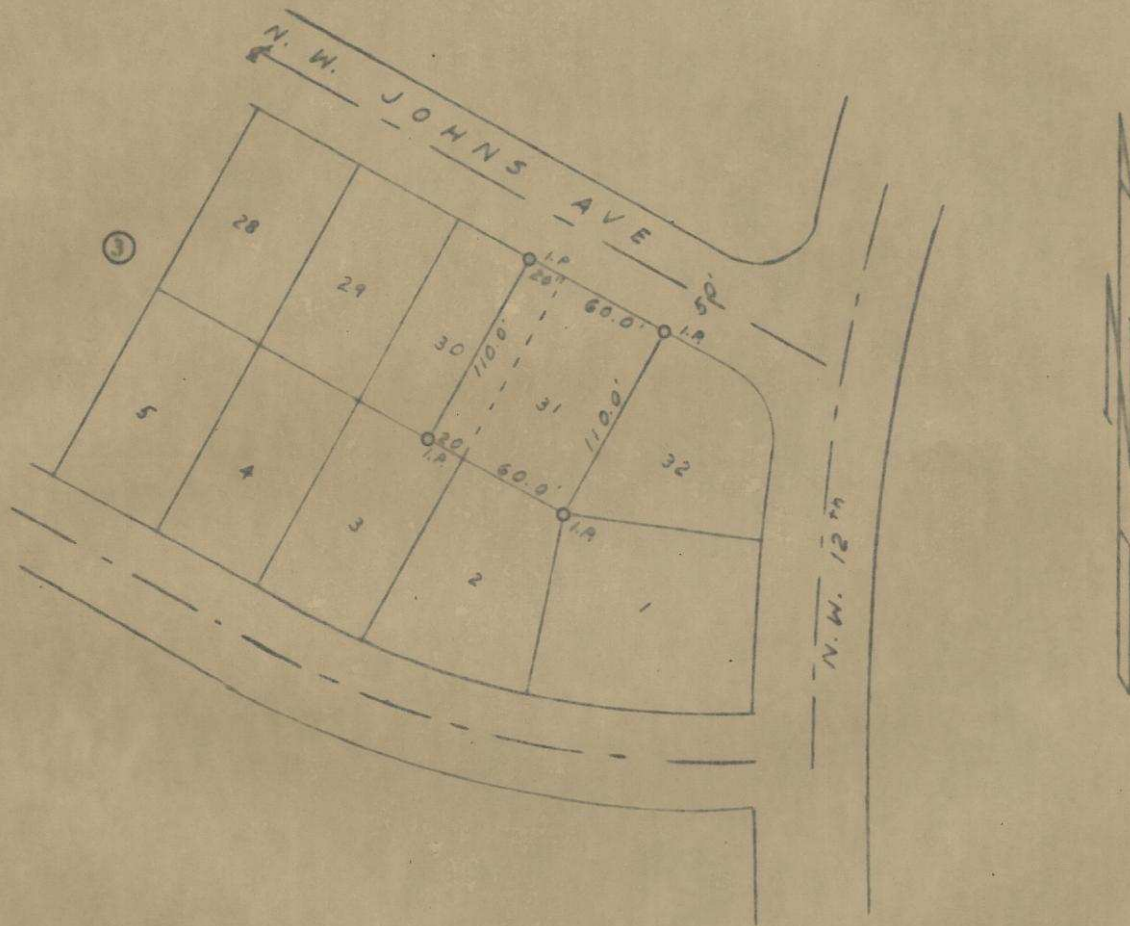

NE4SW4(3)

REGISTERED
OREGON
 LAND SURVEYOR
Wayne O Harris
 WAYNE O. HARRIS
 346

HAYES AND HARRIS			
Survey For			
PENDLETON HOUSING CORPORATION			
Lot 31 & E. 20' Lot 30			
Block 3 Q-157-AX			
West Hills Add'n, Pendleton, Ore.			
Scale	Date	Drn. By	Drng. No.
1"-100'	2/12/58	WOH	58-57