
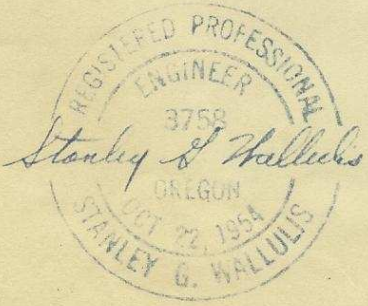


Q-164-AX

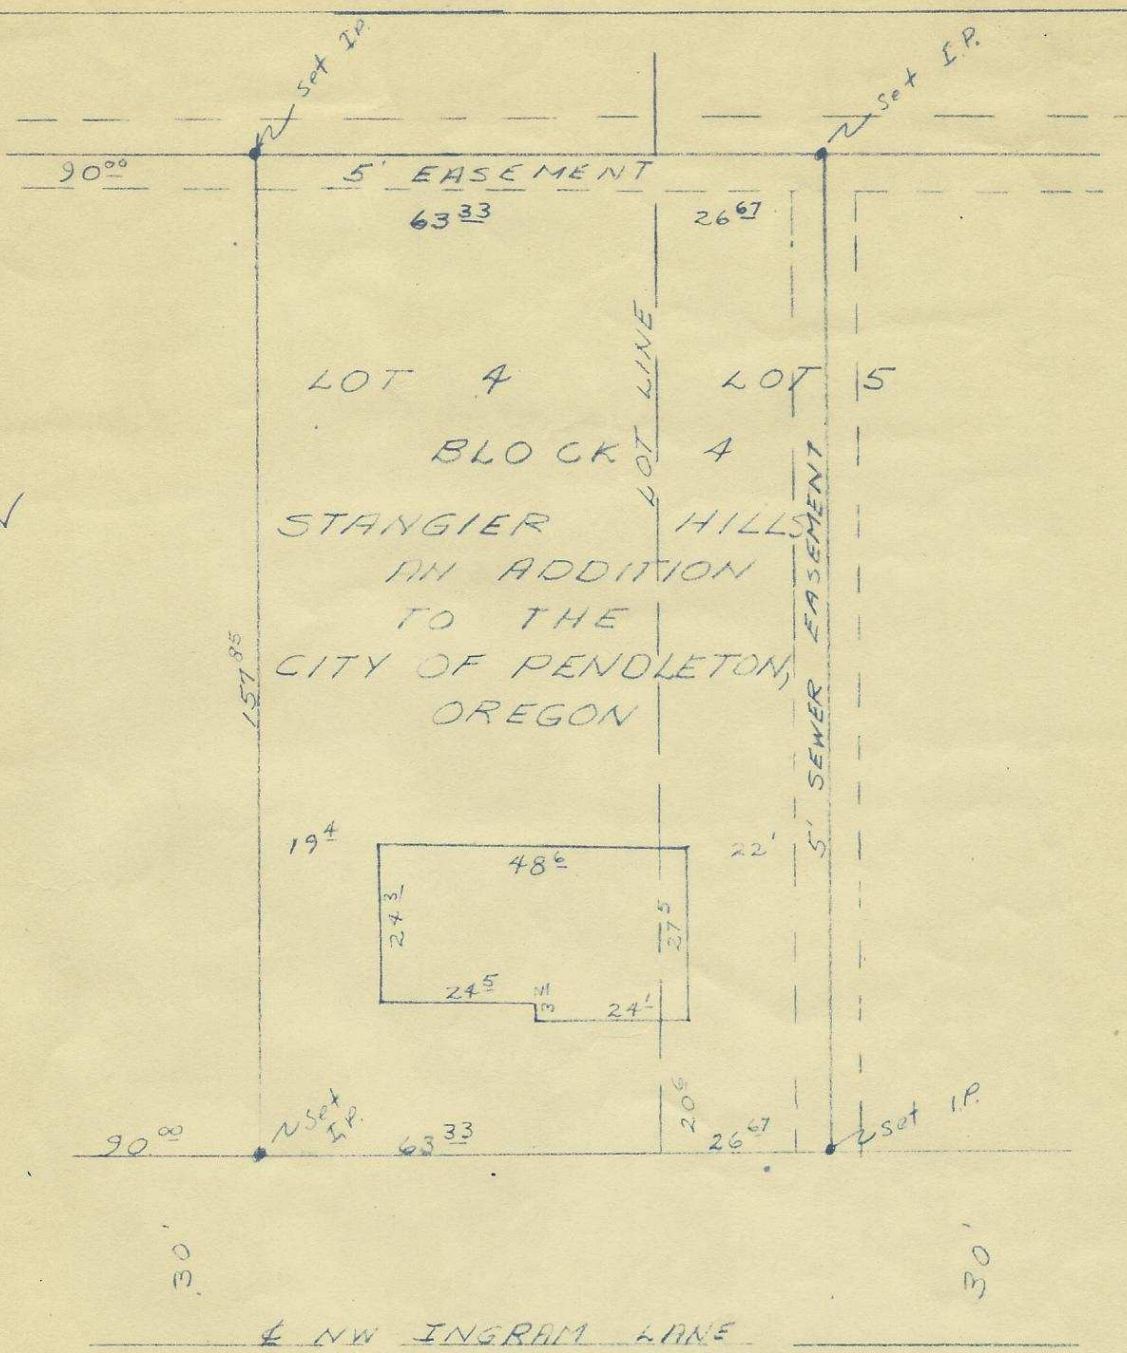

NEW SEW<sup>4</sup>(3) Q-164-AX

PLOT PLAN FOR SHERWOOD & ROBERTS	
Scale 1" = 30'	DATE: 10-21-58
STANLEY G. WALLULIS 409. Consulting Engineer PENDLETON OREGON	