


G-171-Ax

Orig

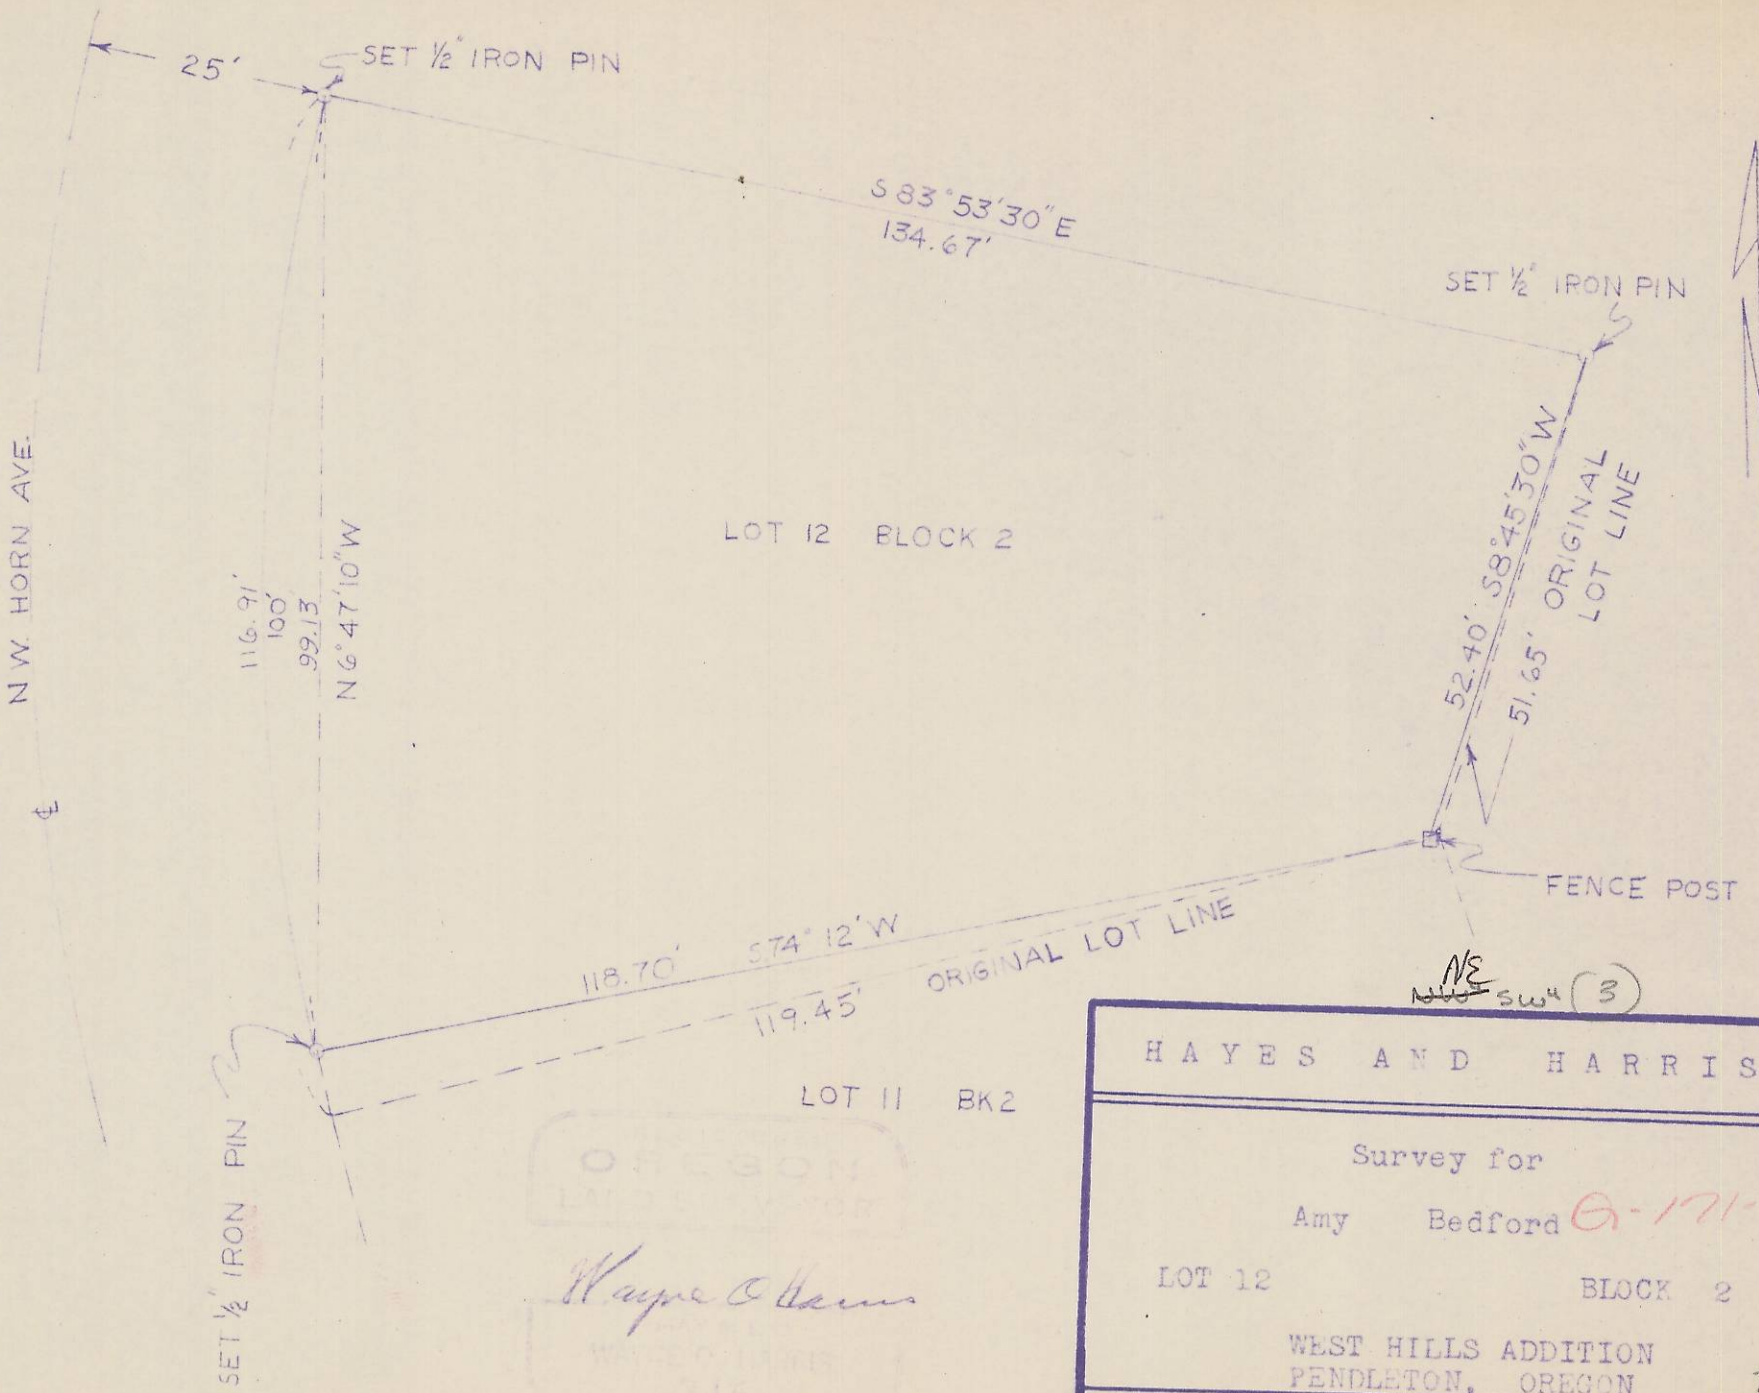

OREGON  
LAND SURVEYOR  
*Hayes & Harris*  
WEST HILLS  
346

HAYES AND HARRIS			
Survey for Amy Bedford <i>G-171-Ax</i>			
LOT 12		BLOCK 2	
WEST HILLS ADDITION PENDLETON, OREGON			
SCALE	DATE	DRN. BY	DRNG. NO.
1"-20'	10/24/60	L.H.A.	

207