


Q-326-Ax

11	175	4
10		5
9		6
8		7

11	174	4
10		5
9		6
8		7

11	173	4
10		5
9		6
8		7

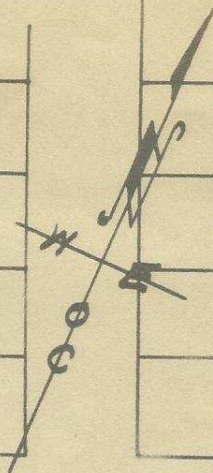

S. E. Hailey

0119

S. E. 5th

14		1
13		2
12		3
11	230	4
10		5
9		6
8		7


S. E. 6th

14		1
13		2
12		3
11	231	4
10		5
9		6
8		7

S. E. 7th

14		
13		
12		
11	232	
10		5
9		6
8		7

S. E. 15⁰⁰⁰

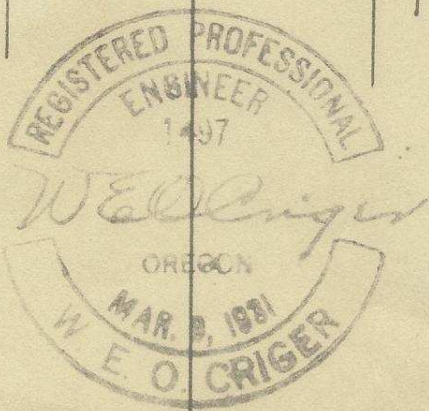

Plat of Block 231 of
 Reservation Addition to
 The City of Pendleton, Oregon.
 Scale: 1 inch = 100 Feet.
 Surveyed, Staked, & Platted, May-1948.
 By W. E. O. Criger.

SW¹ & NW¹ (1)
 SE¹ & NW¹

Q-326-Ax