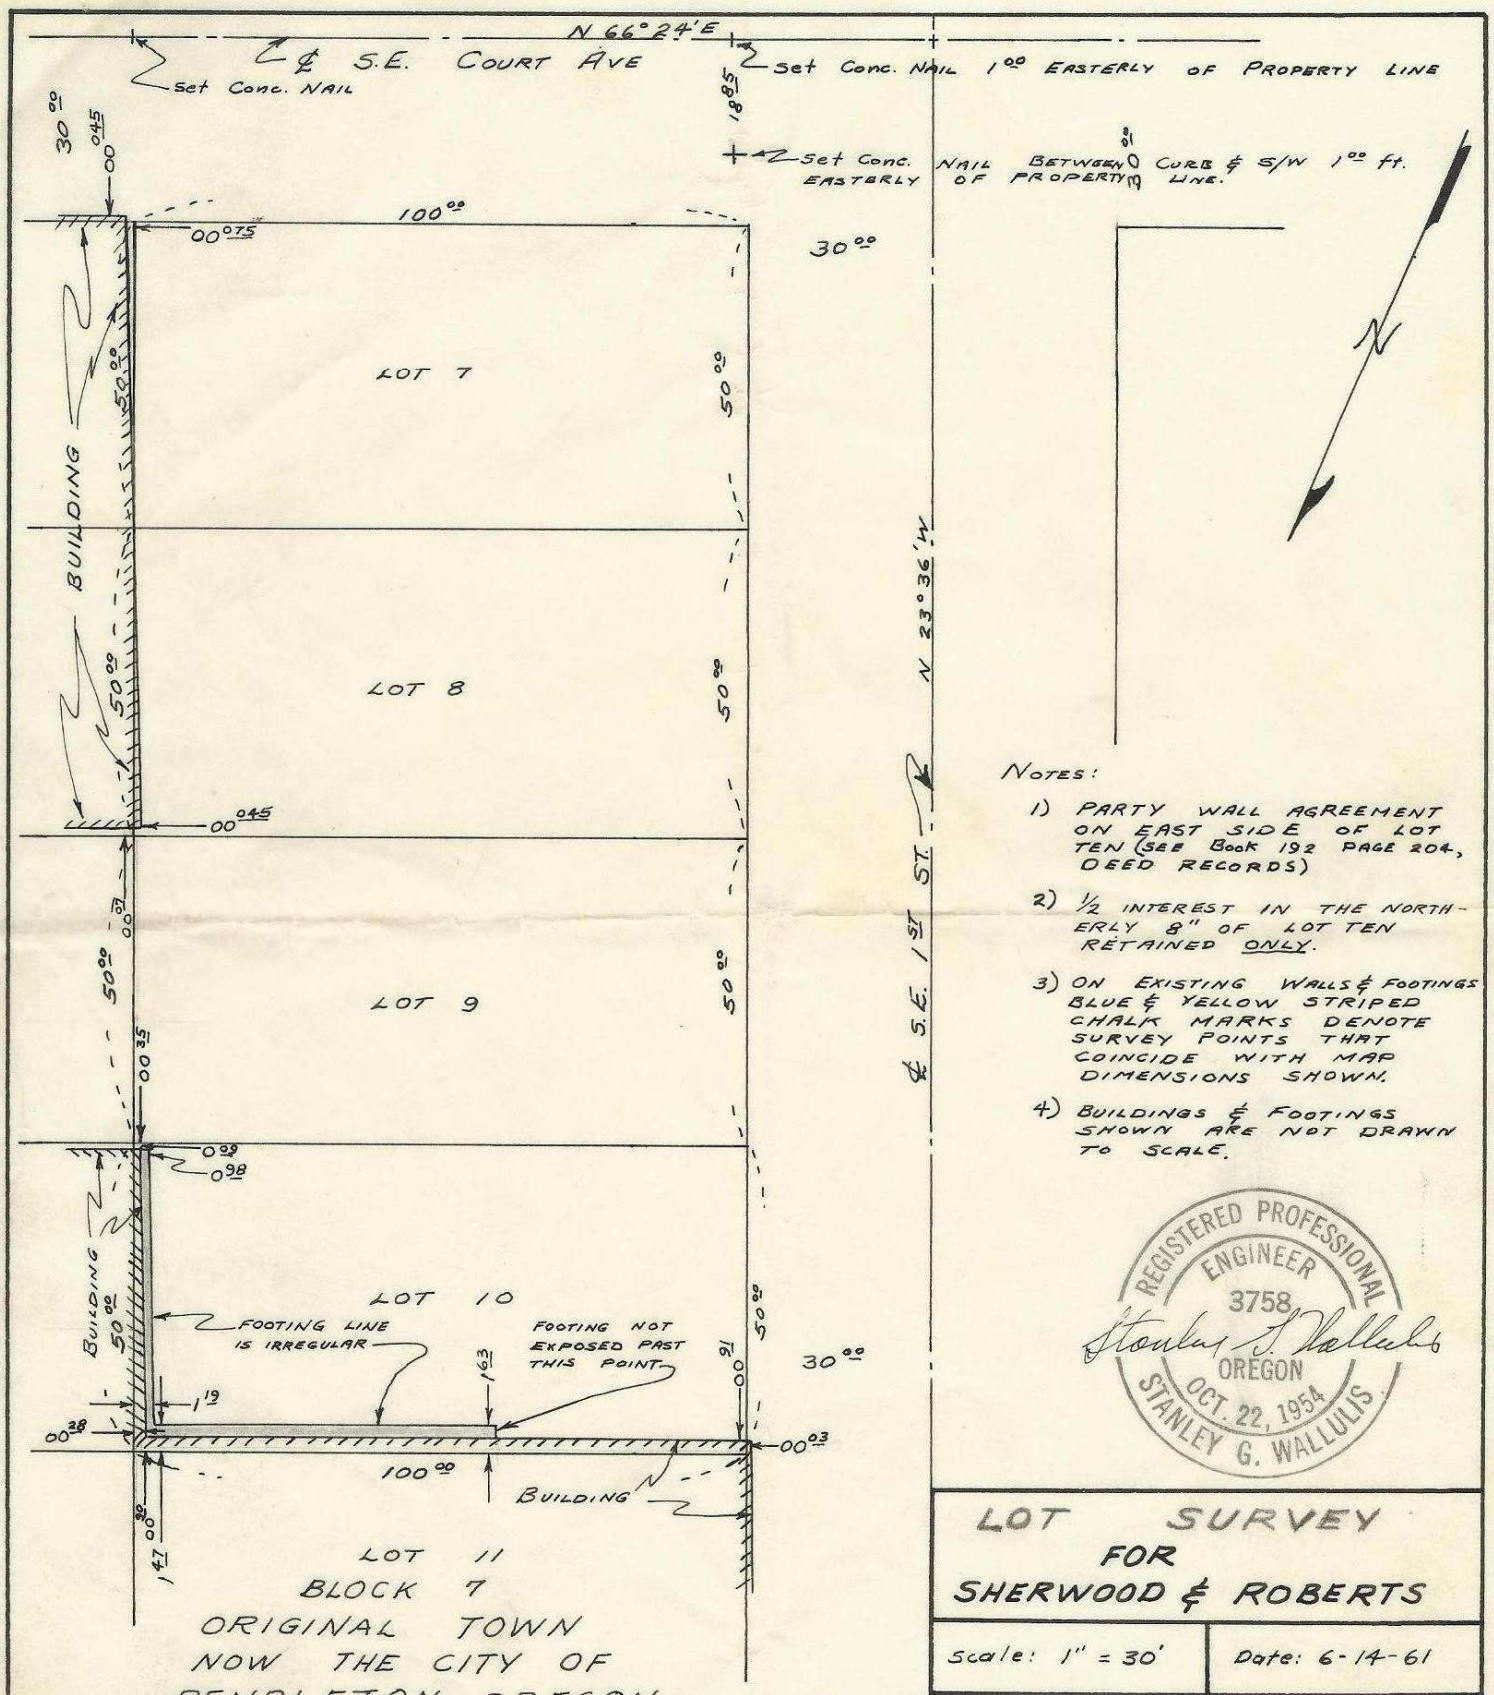

NOTES:

1) PARTY WALL AGREEMENT ON EAST SIDE OF LOT TEN (SEE Book 192 PAGE 204, DEED RECORDS)

2) ½ INTEREST IN THE NORTHERLY 8" OF LOT TEN RETAINED ONLY.

3) ON EXISTING WALLS & FOOTINGS BLUE & YELLOW STRIPED CHALK MARKS DENOTE SURVEY POINTS THAT COINCIDE WITH MAP DIMENSIONS SHOWN.

4) BUILDINGS & FOOTINGS SHOWN ARE NOT DRAWN TO SCALE.

REGISTERED PROFESSIONAL ENGINEER
3758
Stanley G. Wallulis
OREGON
OCT. 22, 1954
STANLEY G. WALLULIS

LOT SURVEY
FOR
SHERWOOD & ROBERTS

Scale: 1" = 30'

Date: 6-14-61

STANLEY G. WALLULIS
CONSULTING ENGINEER
P.O. Box 91
PENDLETON OREGON

2N32 11BB

Q-384-Ax