



Set  $\frac{5}{8}$ " x 30" Rod one foot west of the north-south Lot line and on the east-west Lot line

Set  $\frac{5}{8}$ " x 30" Rod one foot west of the north-south Lot line and on the east-west Lot line

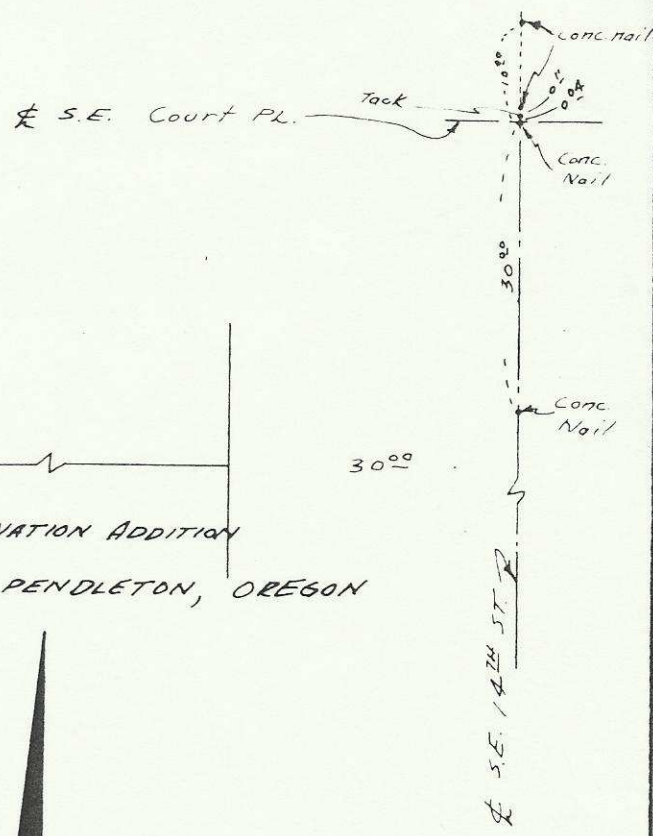

BLOCK 130, RESERVATION ADDITION  
TO THE CITY OF PENDLETON, OREGON

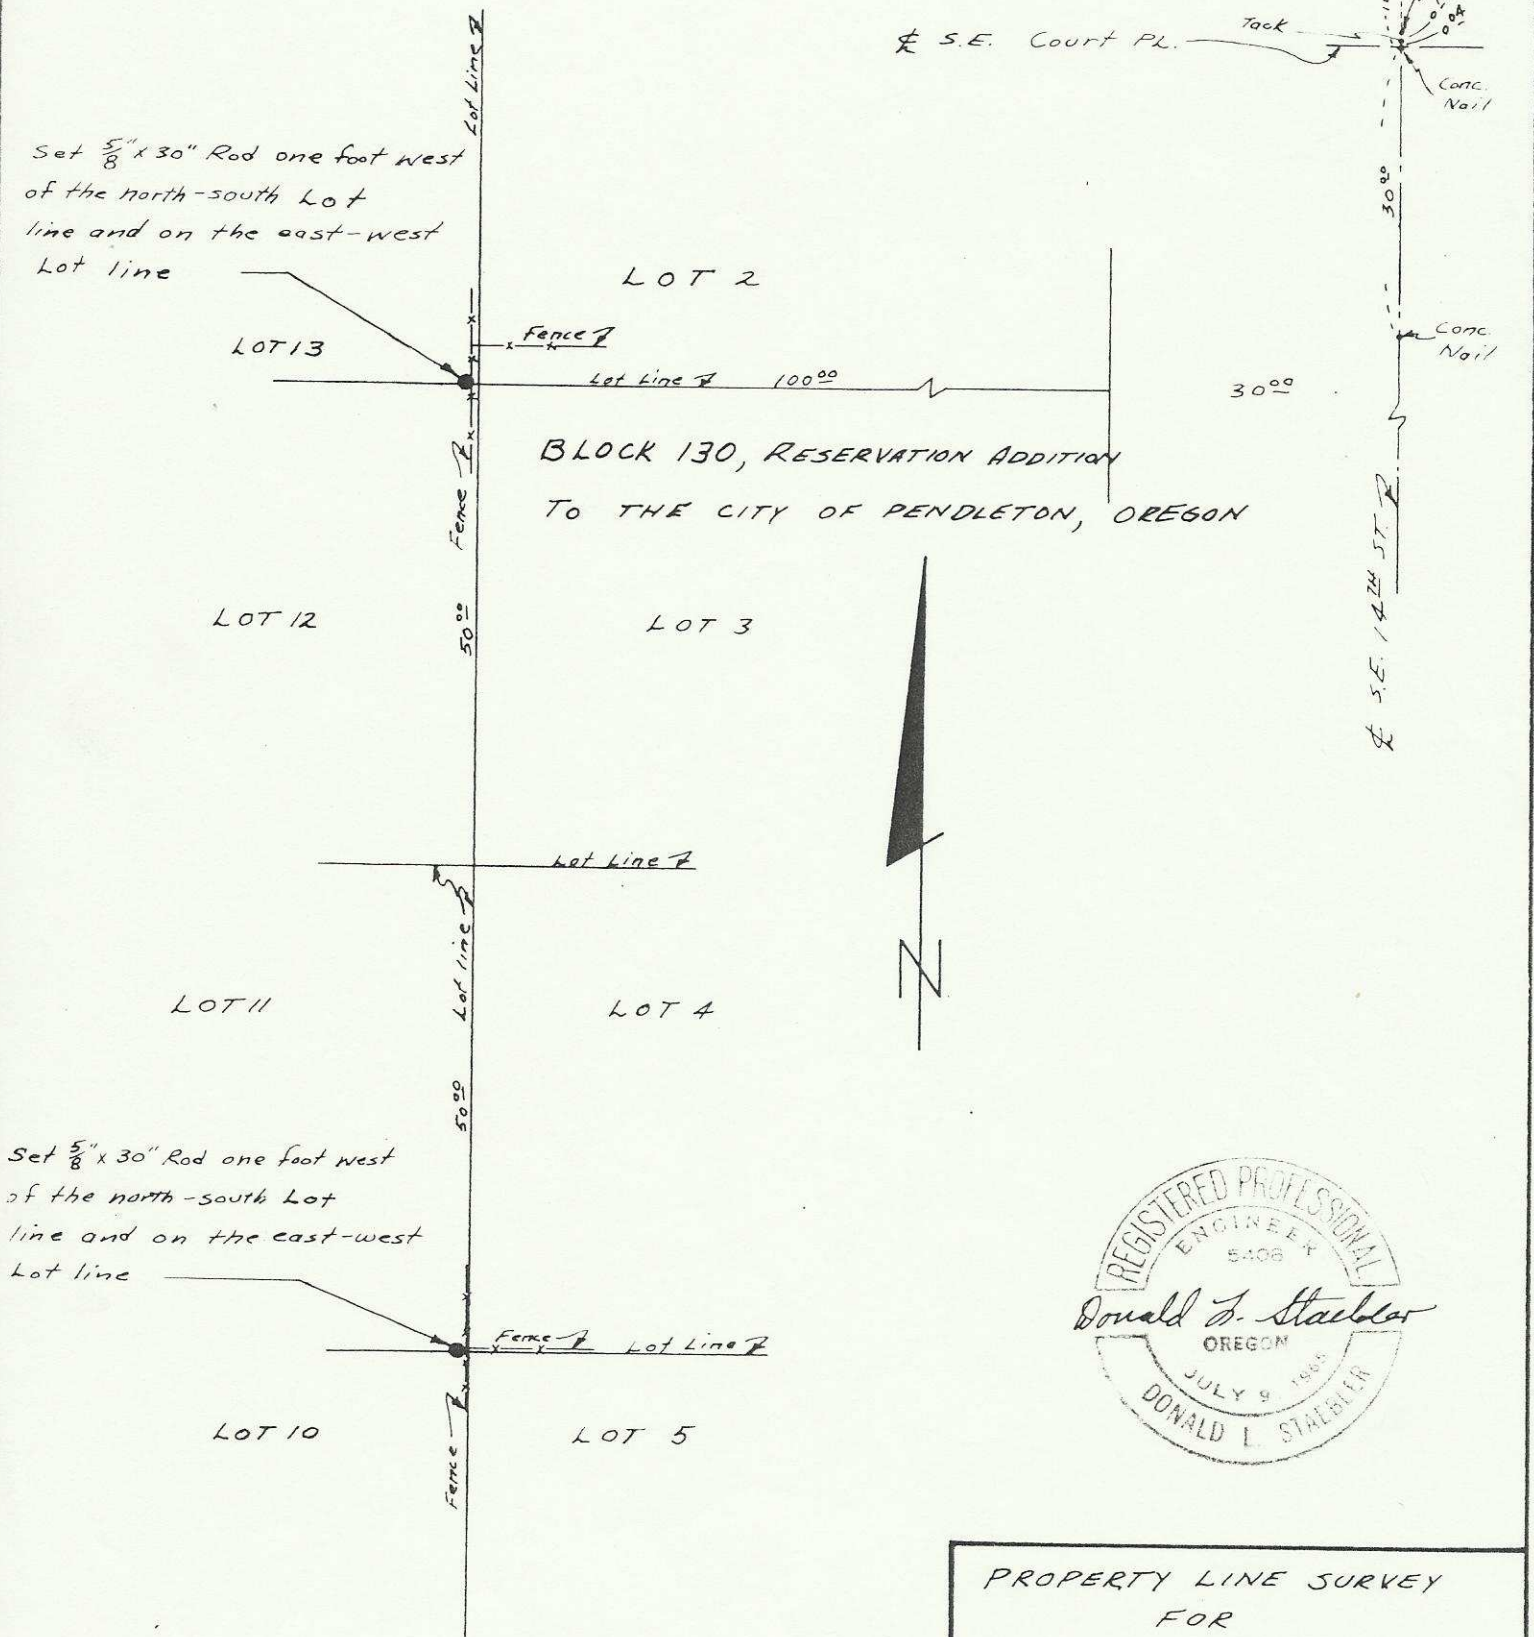

PROPERTY LINE SURVEY  
FOR  
MRS. WILLIAM HAMM

DR BY D.L.S.	DATE 6-18-66	SCALE: 1"=20'
--------------	--------------	---------------

WALLULIS & STAEBLER  
CONSULTING ENGINEERS  
P.O. Box 91

Q-355-Ax  
2N3211AB