

33

Gone (Except Stump Hole)

1/2 of SW/4 Sec. 33 - Mr. Clifton.

(start) →

24" Pine: still Alive - Faces O.K. but Fire Has made Scribing Unreadable.

40 ch. 52297
2640' S. 89° 39' E.
(Mag. Var. = 20° 00')

Set. Corner Post.

40 ch. = 2640'

N. 40° E.
18 Lks. = 1109' 10" Larch.

T. 4 N., R. 36 E., W. 1/4 M.
T. 3 N., R. 36 E.

S. 76° W.
20 Lks. = 133'

20" Larch -
These B. Trees have all been destroyed - (corner identifiable from other forms of progressive activities).

S. 30° E.
22 Lks. = 145'


5" Larch -

36" Pine
Stump O.K. but - Tree fallen and in bad state of decay but still identifiable.

36" Pine S. 40° W.
18 Lks. = 1182'
Fallen
Marking Unhurt
Part on Fallen Tree - partly on Stump -

4

3N 36

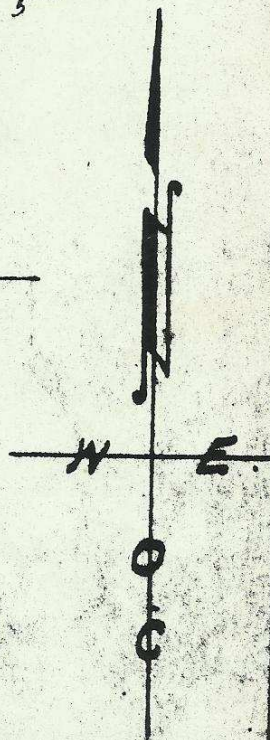

File -
Jury or
Co. Court House.

Map showing
Sec. 4. T. 3 N., R. 36 E., W. 1/4 M.
Umatilla County, Ore.
surveyed, staked & plotted, Oct. 1953 -
By W.E.O. Criger -

Scale: 1 inch = 1000 Feet.
Part of Sec. 33 - T. 4 N., R. 36 E., W. 1/4 M. Show -
same scale.

Geo. Bishop - Atty - M-F.

Mr. E. L. Mitchell - Weston - Phone Mrs. Lee Crigin - 212 (Daughter)

See Joe Clifton - R. L. Weston

Julia M. Kerner
Box 99 -
or Ph. 272

0-5-38-AX

1102