SURVEY OF COUCH PROPERTY

Q-550-Ax

UMATILLA COUNTY, ORE.

IN THE S.E. 1/4 OF S.W 1/4 OF SECTION 1, T.4N., R.28E., W.M.

SCALE: 1"=100'

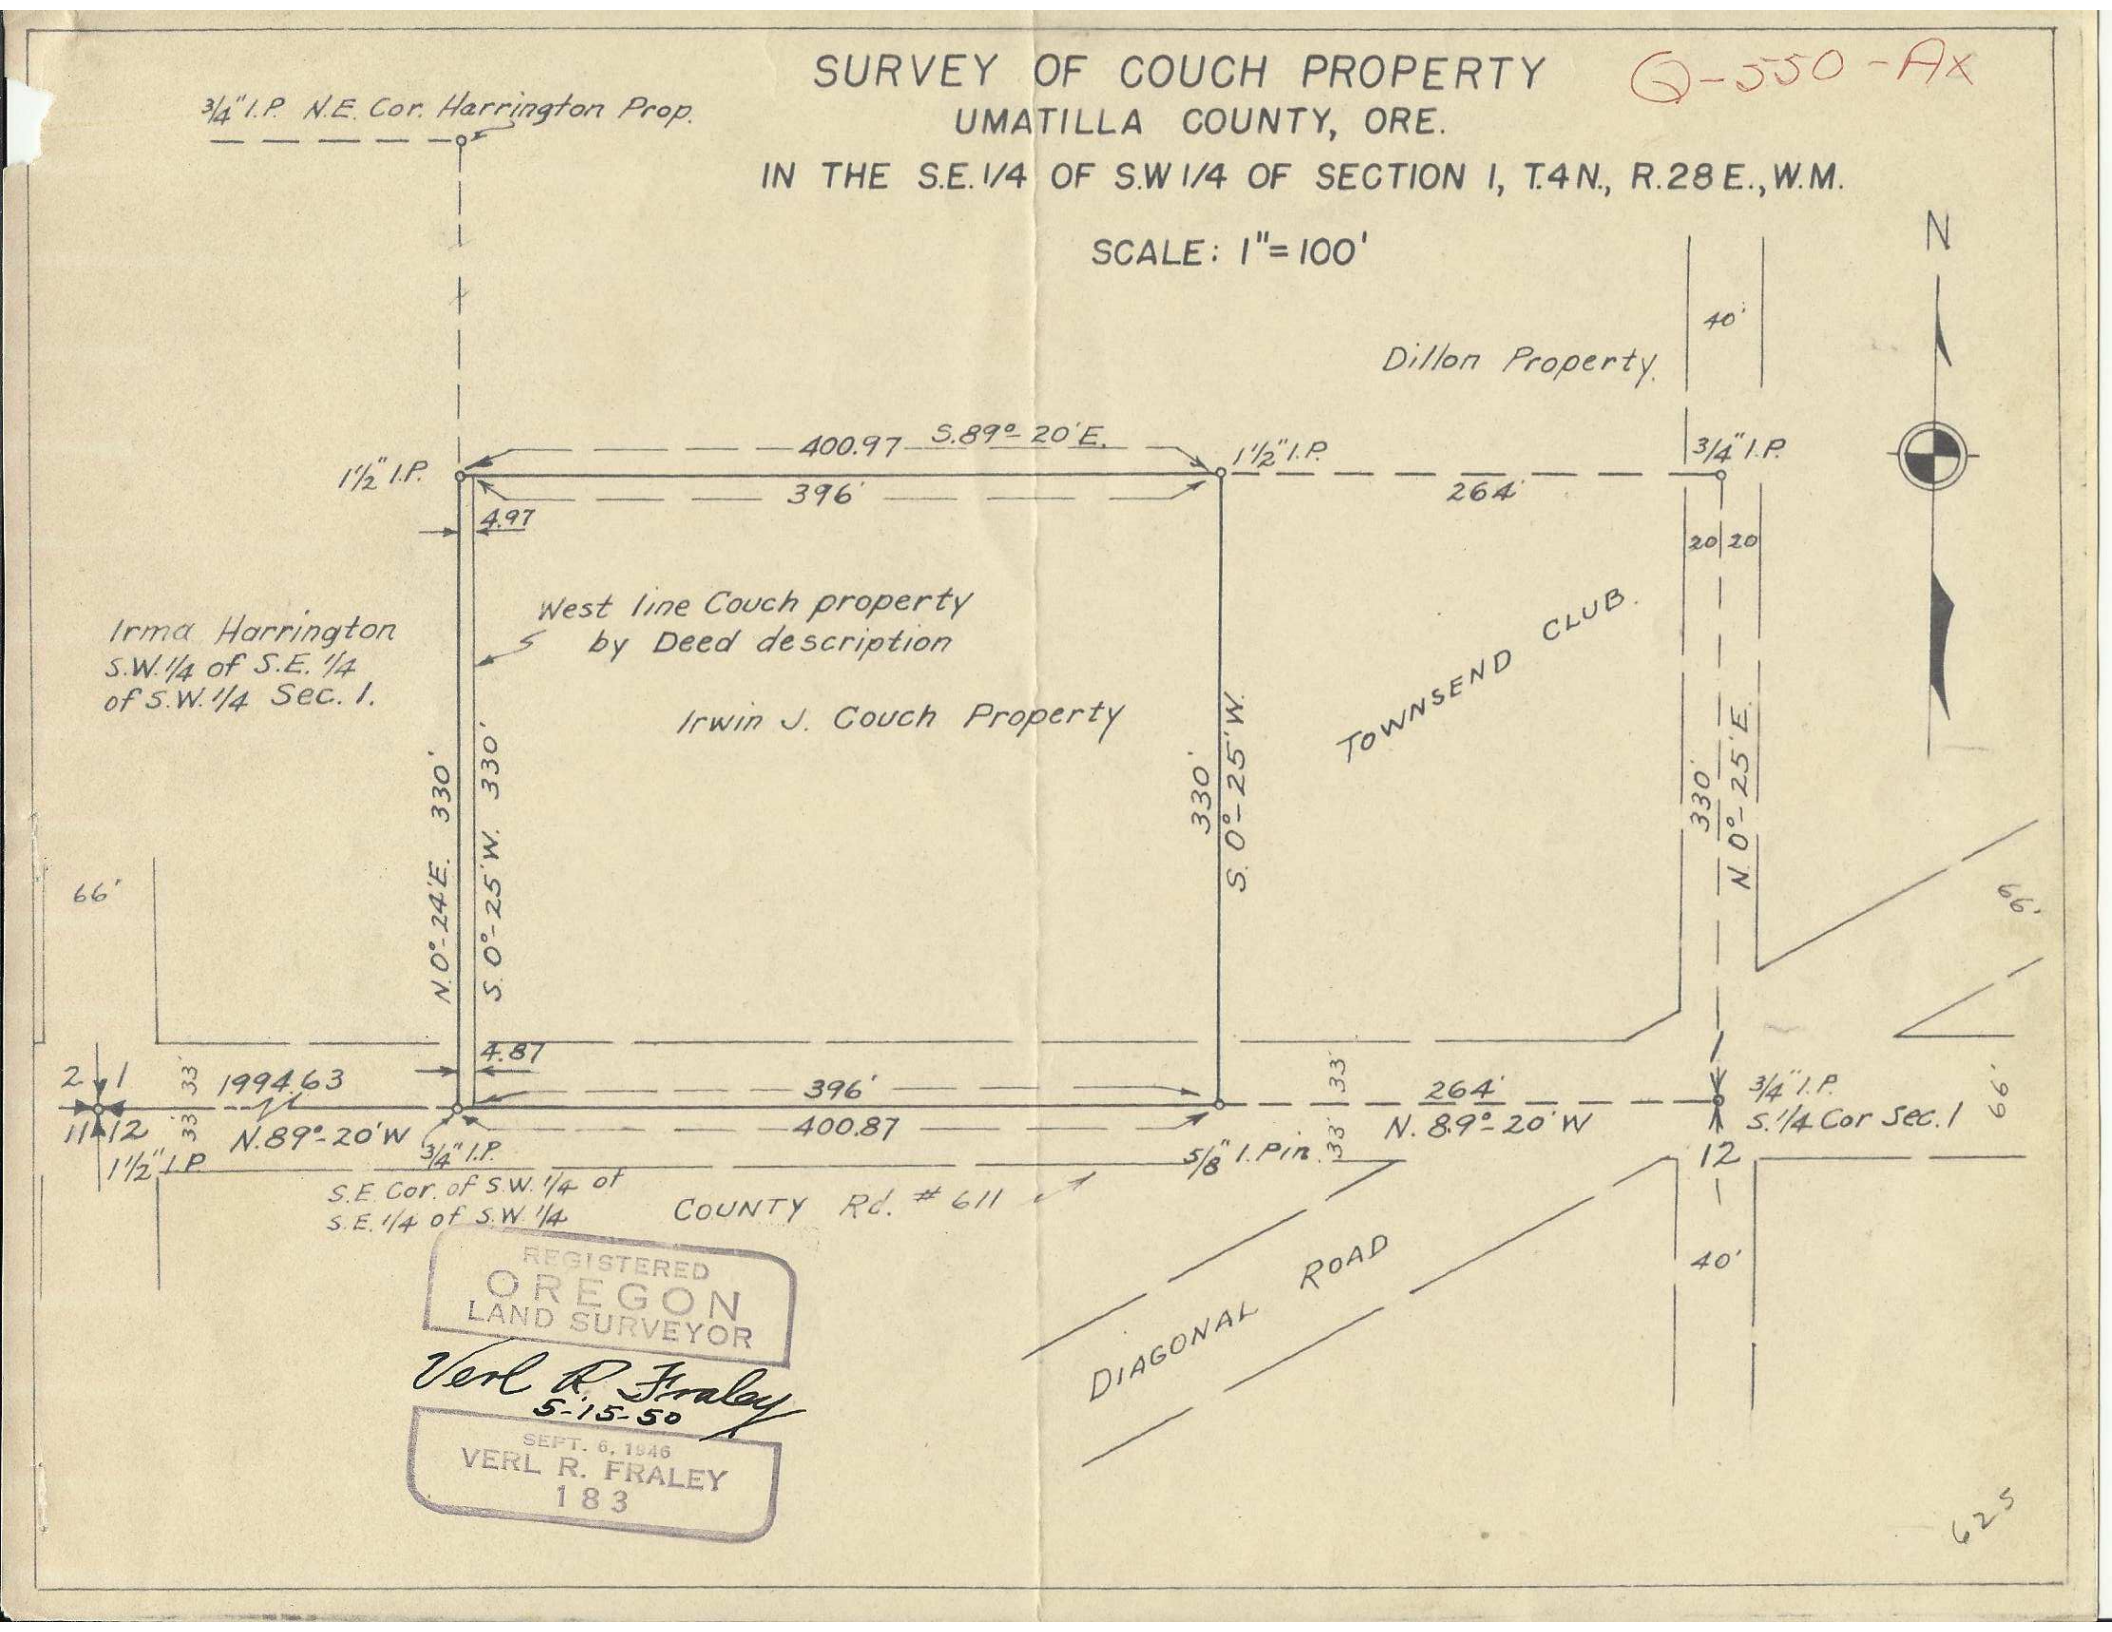

REGISTERED OREGON LAND SURVEYOR

Verl R. Fraley

5-15-50

SEPT. 6, 1946

VERL R. FRALEY

183

625