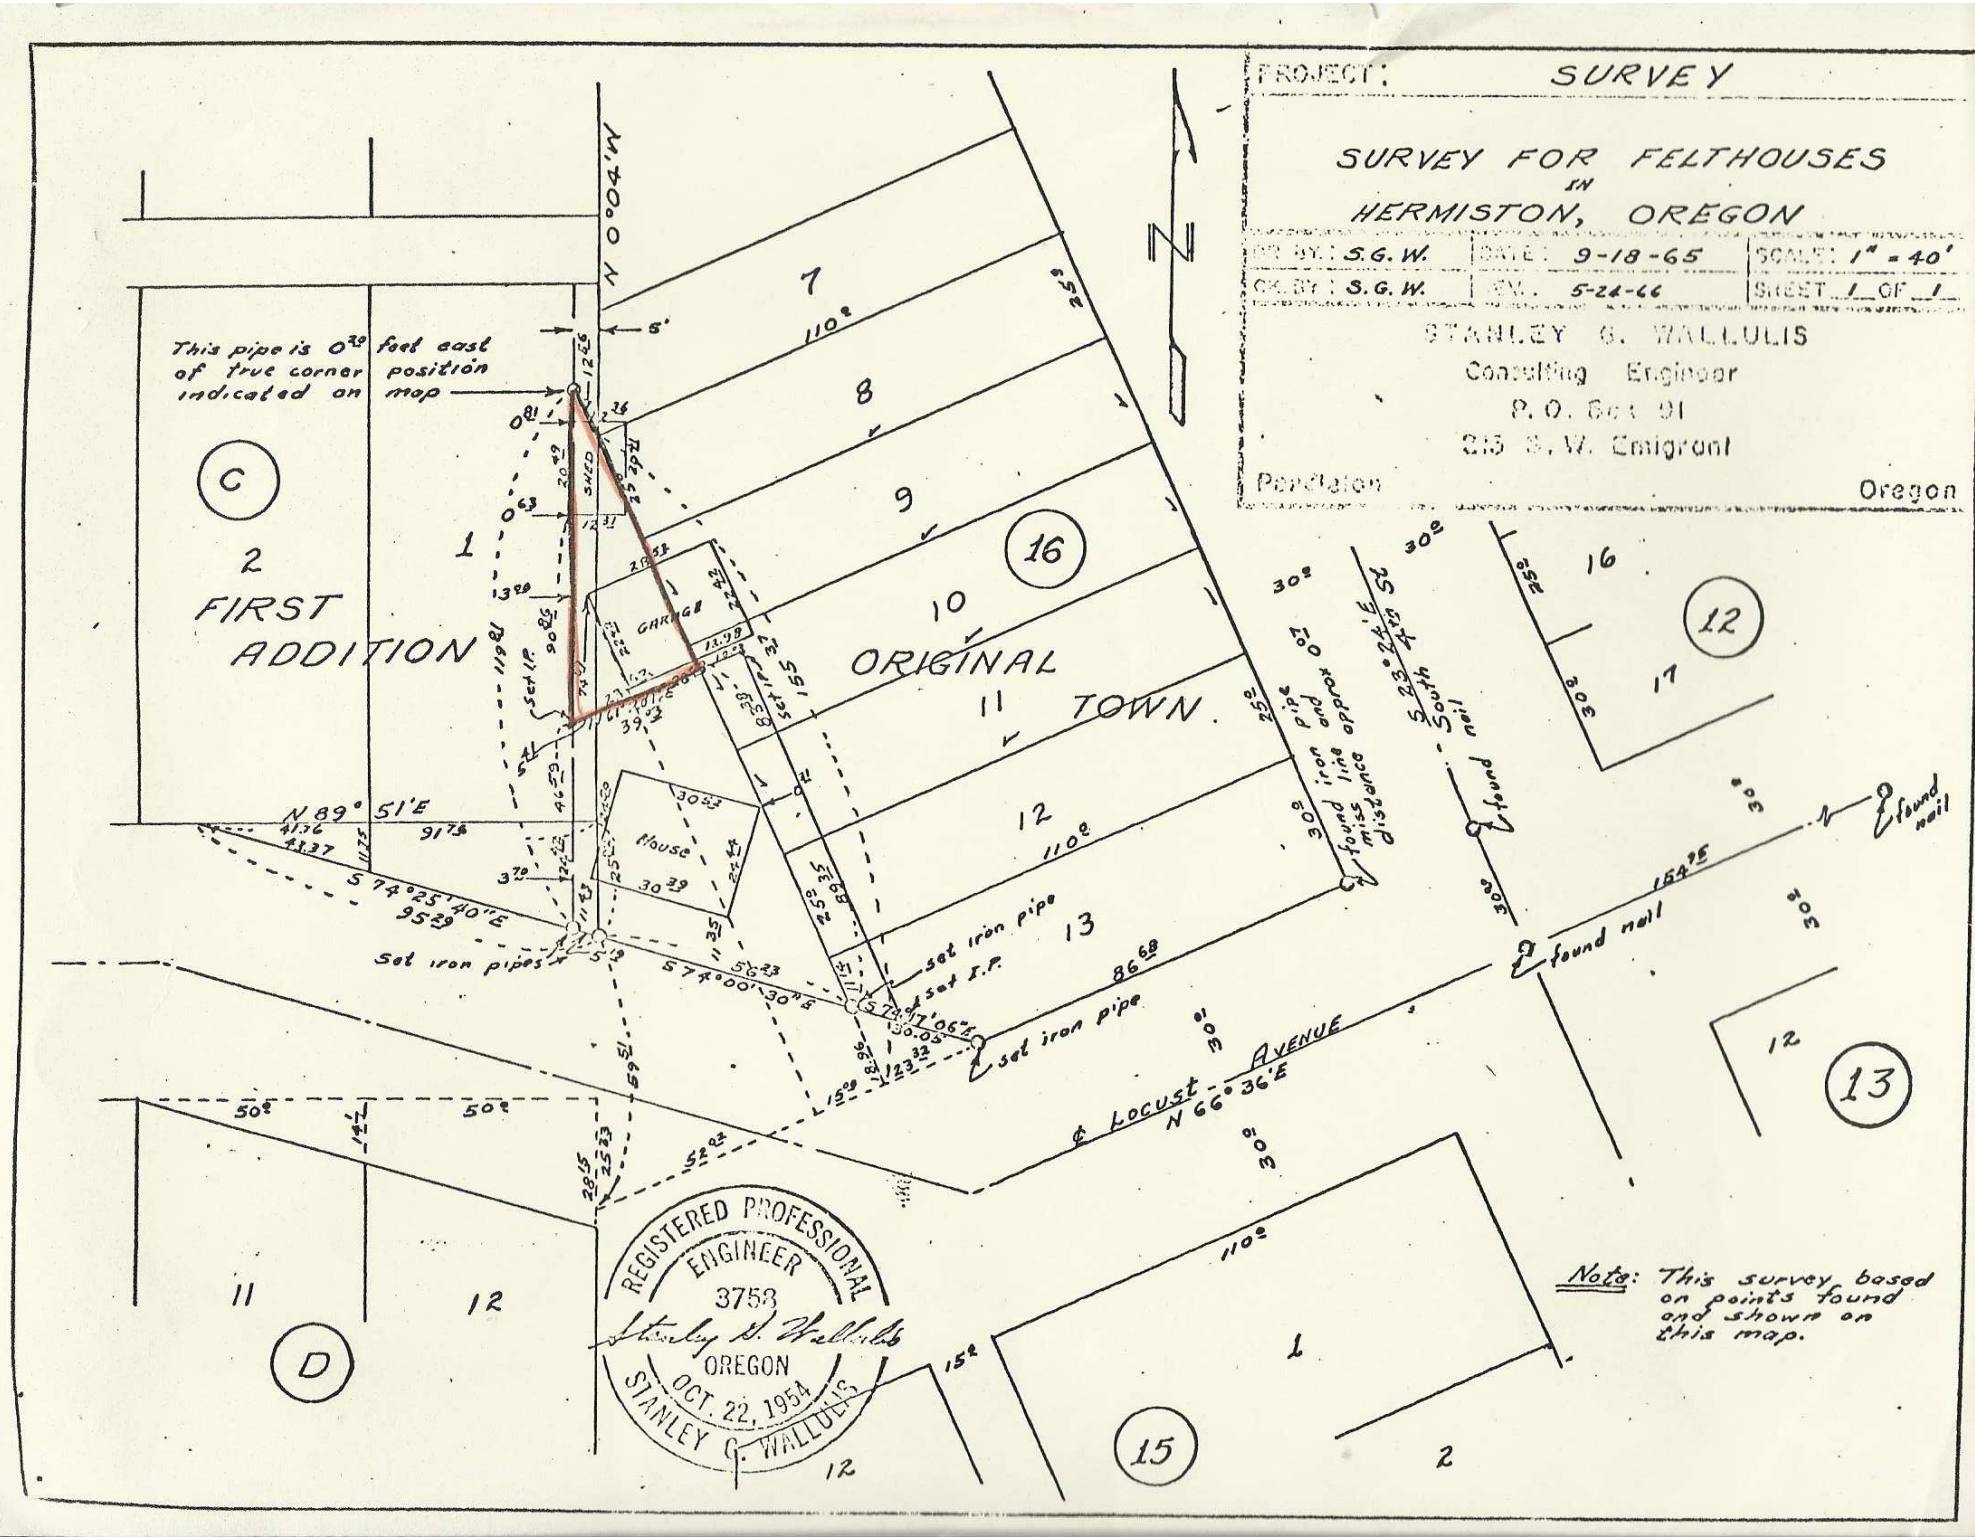
PROJECT: SURVEY
SURVEY FOR FELTHOUSES
IN
HERMISTON, OREGON
DR. BY: S.G.W.
DATE: 9-18-65
SCALE: 1" = 40'
CK. BY: S.G.W.
REV. 5-24-66
SHEET 1 OF 1
STANLEY G. WALLULIS
Consulting Engineer
P. O. Box 91
215 S.W. Emigrant
Pendleton
Oregon
This pipe is 0.29 feet east of true corner indicated on map
N 0°04' W
FIRST ADDITION
ORIGINAL TOWN
HERMISTON
SHED
GARAGE
House
Set iron pipes
Set iron pipe
Set I.P.
Found nail
N 89° 51' E
S 74°25'40" E
S 74°00'30" E
S 74°11'06" E
N 66°36' E
Locust Avenue
REGISTERED PROFESSIONAL ENGINEER
3753
Stanley G. Wallulis
OREGON
OCT. 22, 1954
STANLEY G. WALLULIS
Note: This survey based on points found and shown on this map.