


2-689-Ax

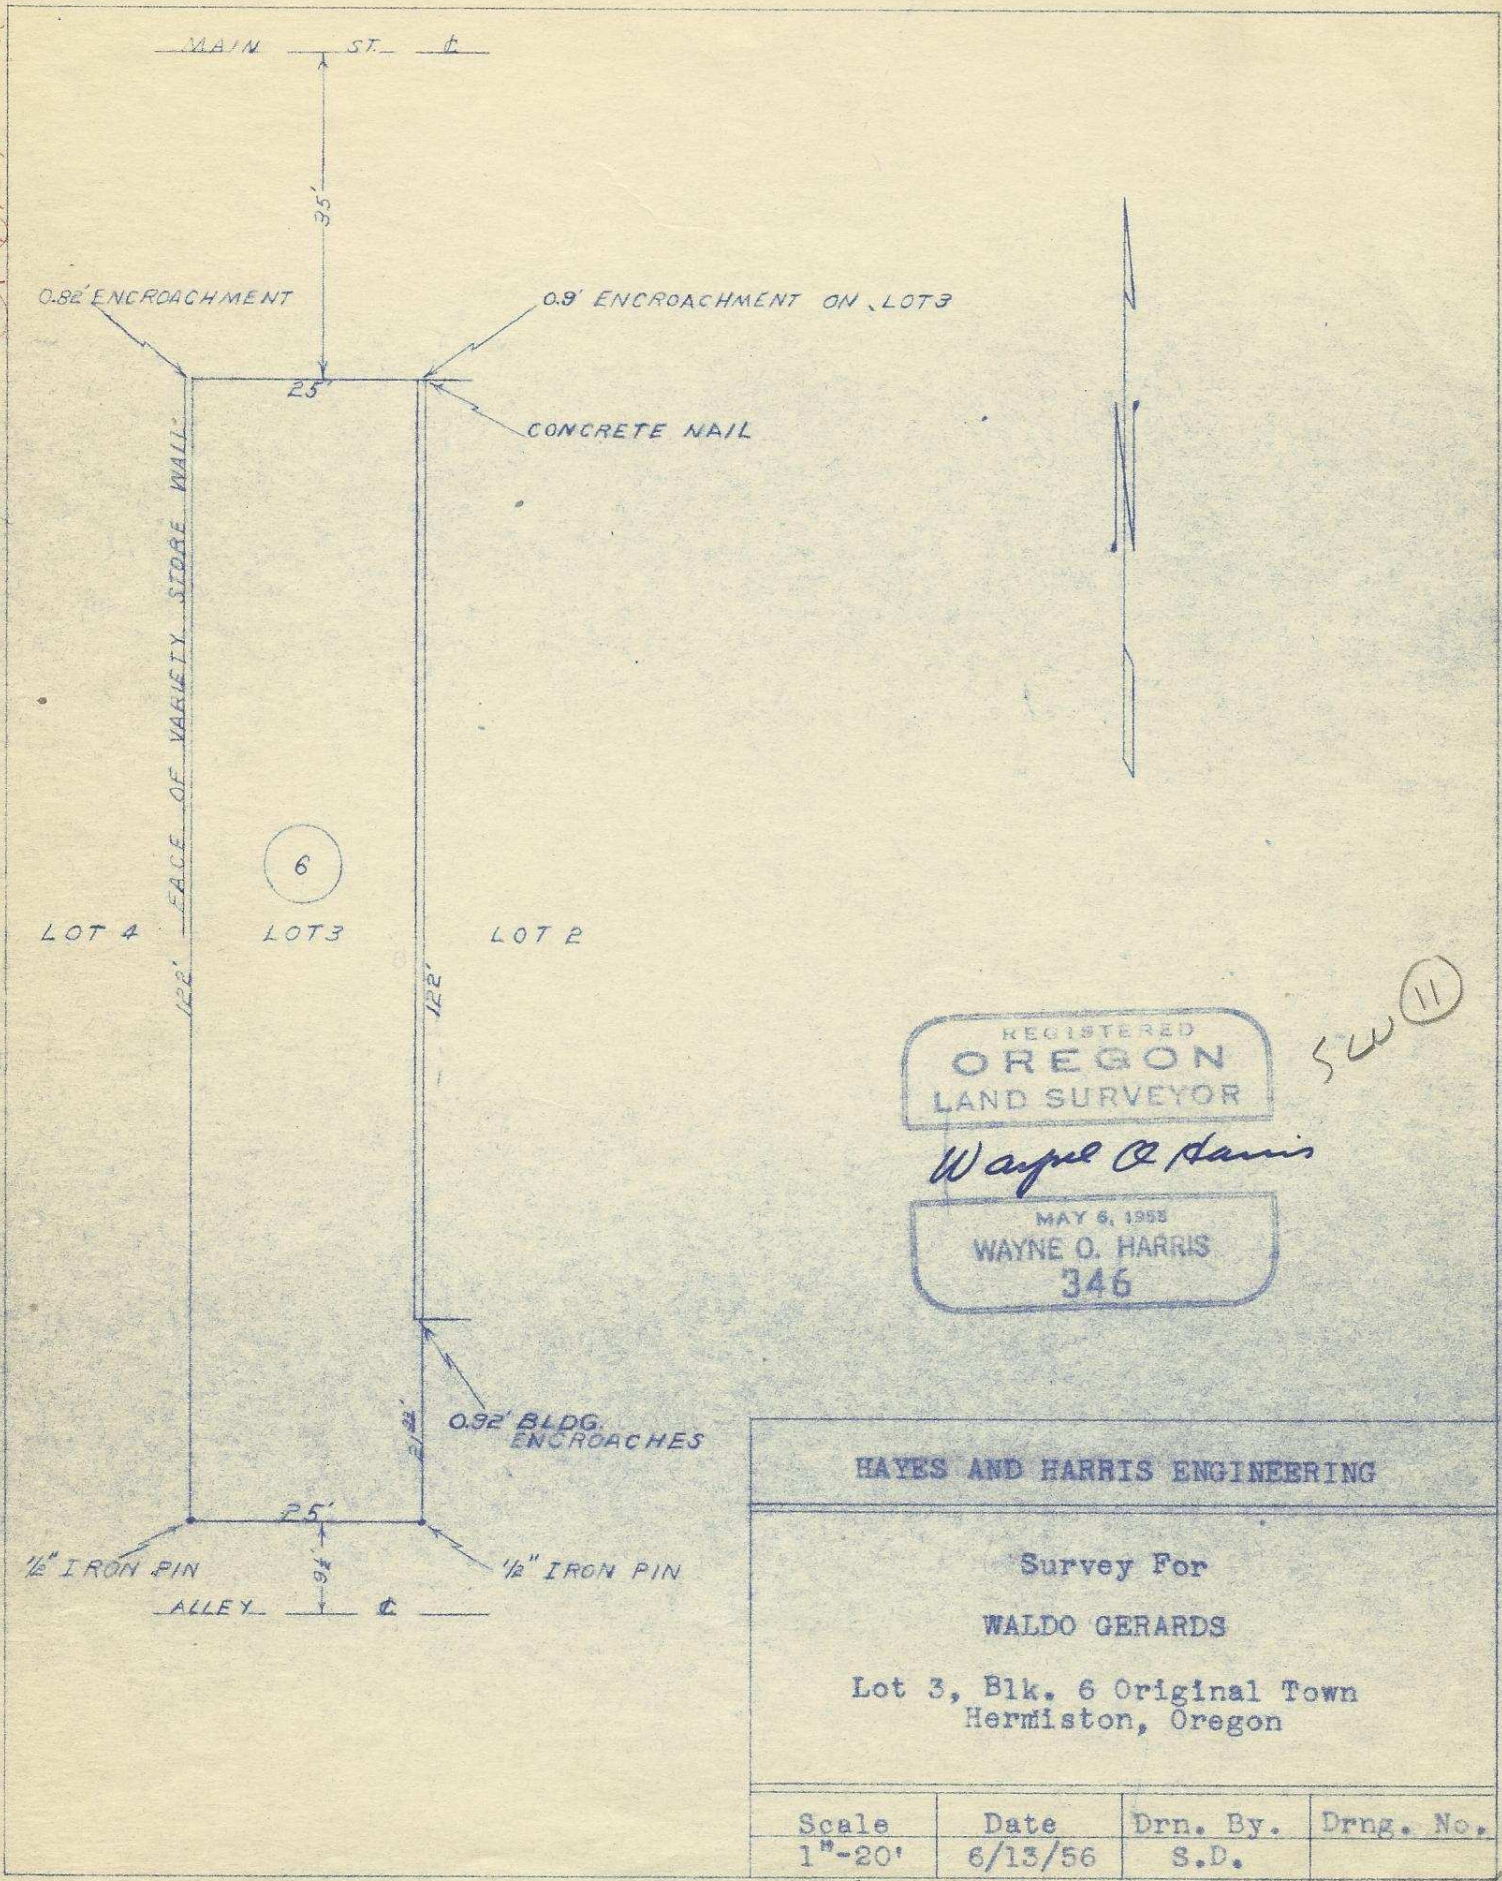

REGISTERED
OREGON
 LAND SURVEYOR

Wayne O. Harris

MAY 6, 1955
 WAYNE O. HARRIS
 346

SW (11)

HAYES AND HARRIS ENGINEERING

Survey For

WALDO GERARDS

Lot 3, Blk. 6 Original Town
 Hermiston, Oregon

Scale	Date	Drn. By.	Drng. No.
1"=20'	6/13/56	S.D.	

HCB

59