


# ELMO E. ROBNETT

Registered Land Surveyor

Box 0176  
MILTON, OREGON

Q-670-AX

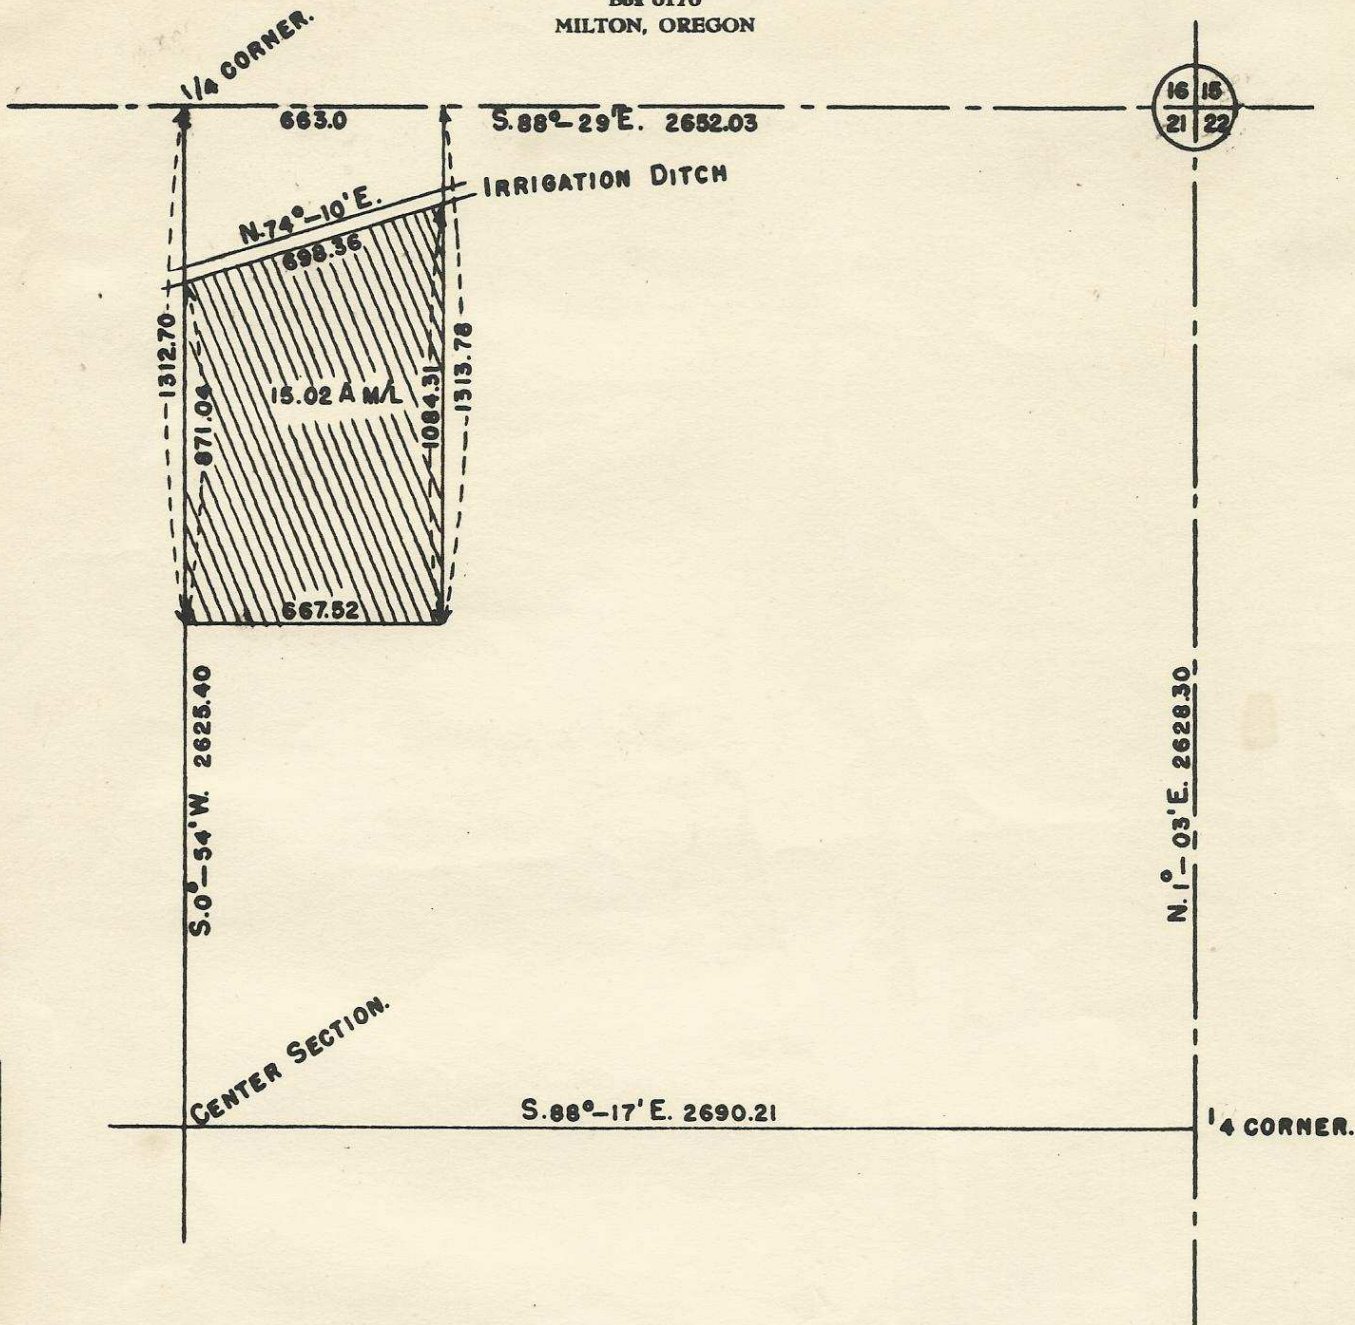

DESCRIPTIVE TRACT.

N.E.  $\frac{1}{4}$  SEC. 21 T. 4 N. R. 28 E. W. M.

SCALE 1" = 500'

OCT. 28 1947.

REGISTERED  
OREGON  
LAND SURVEYOR

*Elmo E. Robnett*

MARCH 8, 1946  
ELMO E. ROBNETT  
169

12/1/47

634