
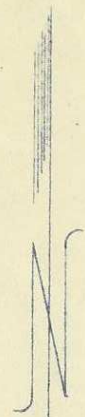


Q-799-AX

5N35-1 C

N.E. CORNER OF W 1/2 SW 1/4  
SEC. 1, TWP 5 N, R 35 E W.M. 2 Rock

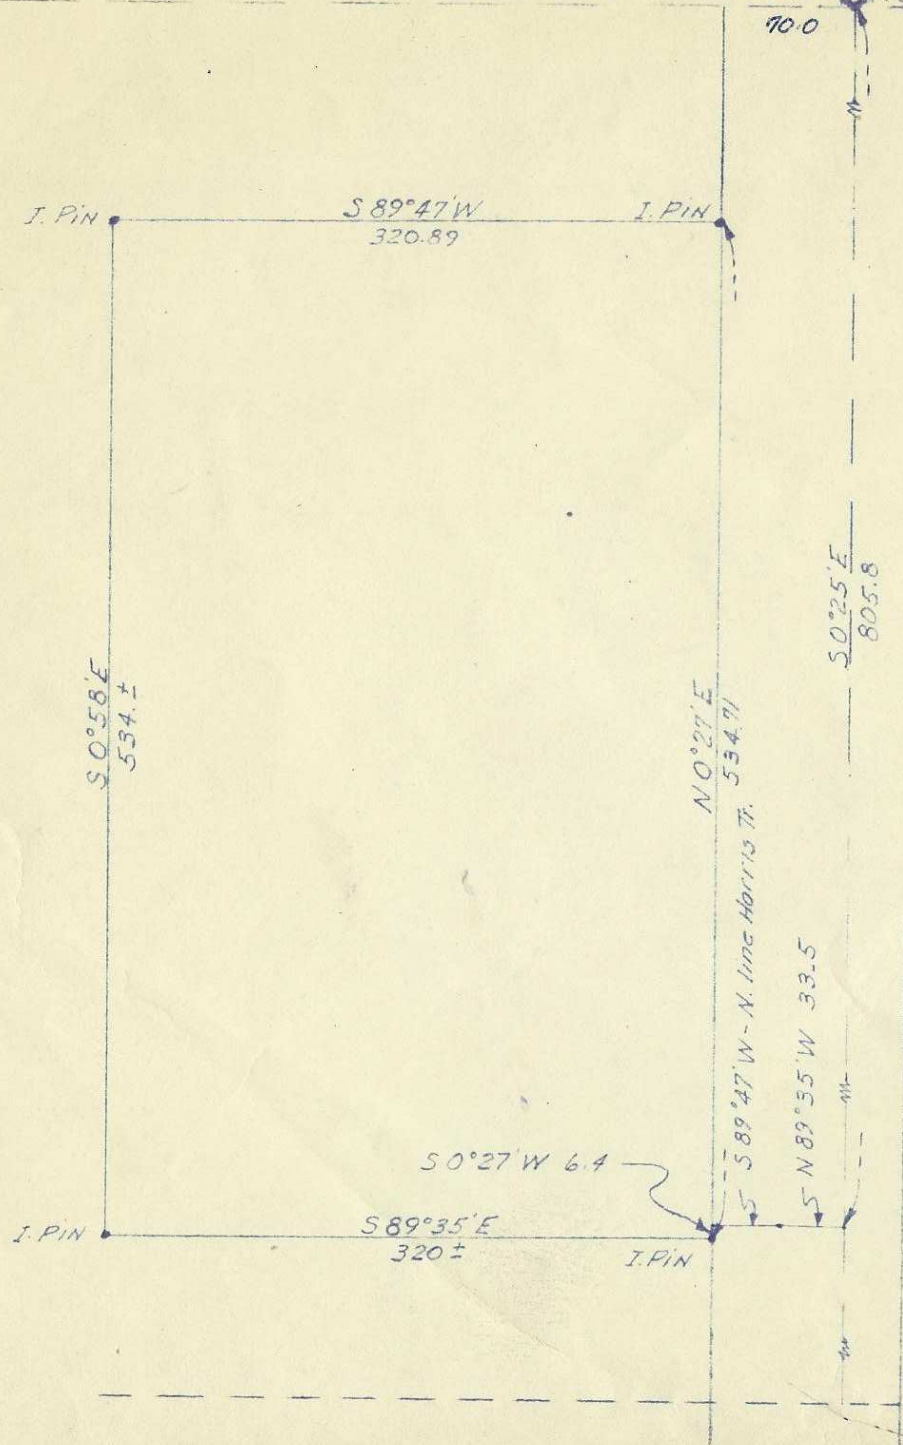

SCALE 1" = 100

G. M. NEWBILL

LICENSED LAND SURVEYOR

17 N. Second

Walla Walla, Wash.

Phone 4170

Surveys  
 Descriptions  
 Sub Divisions

A SURVEY  
 FOR  
 WRINKLE REALTY  
 MILTON-FREEWATER, ORE.

Date 5-2-56  
 Drawn By D.T.D.  
 Checked By G.M.N.

No. 1782

1031