


Q-811-AX

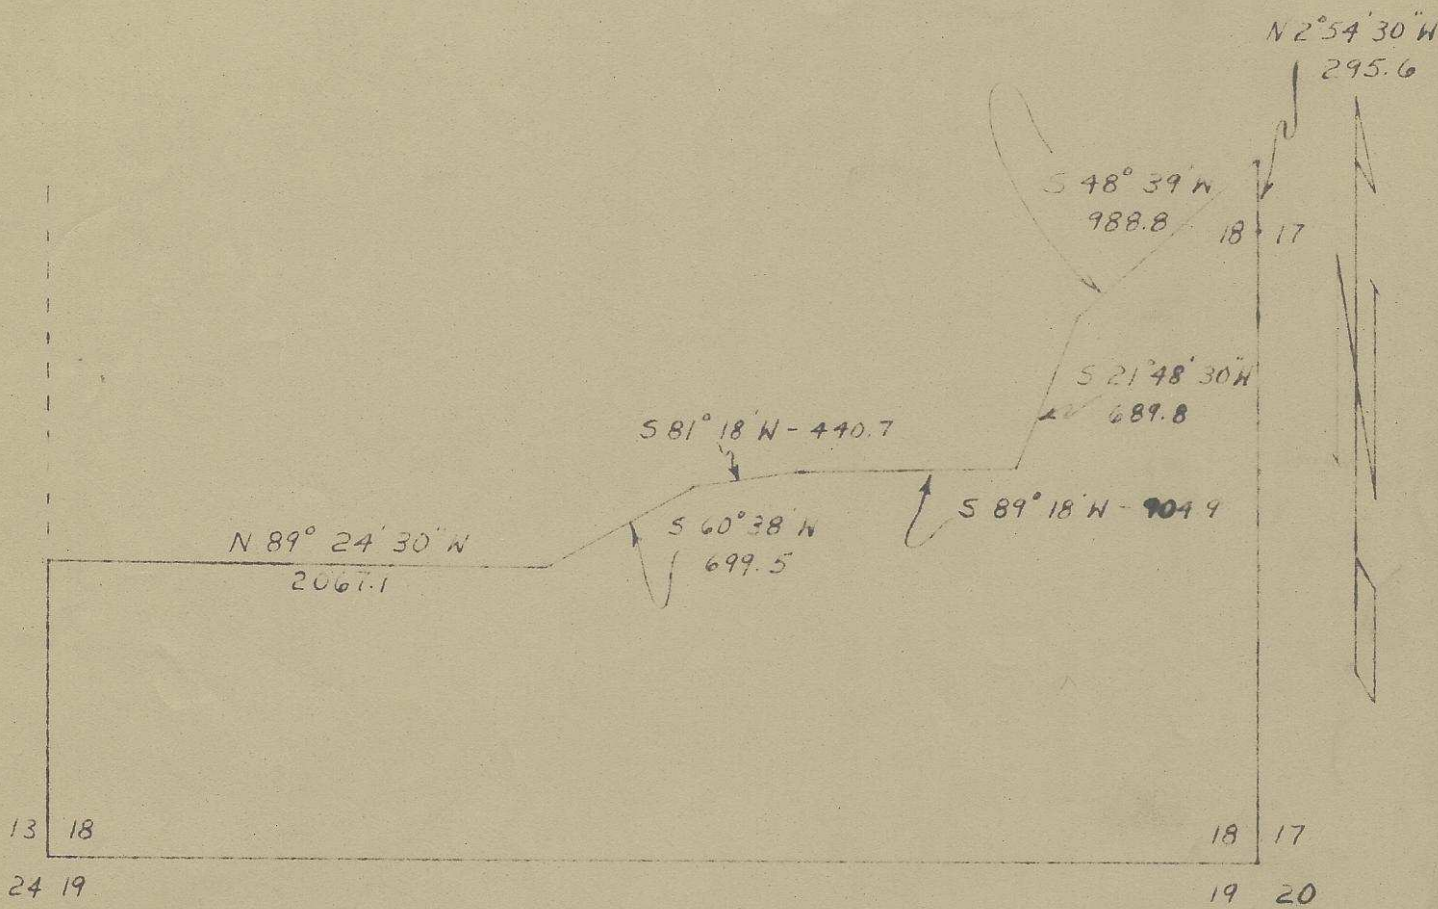

Wayne O Harris

HAYES AND HARRIS			
Survey For LLOYD KEY			
Parcel In Section 18 T. 5 N., R. 37 E., W.M.			
Scale	Date	Drn. By	Drng. No.
1"=300'	5/11/60	WOH	60-120