


Q-826-Ax

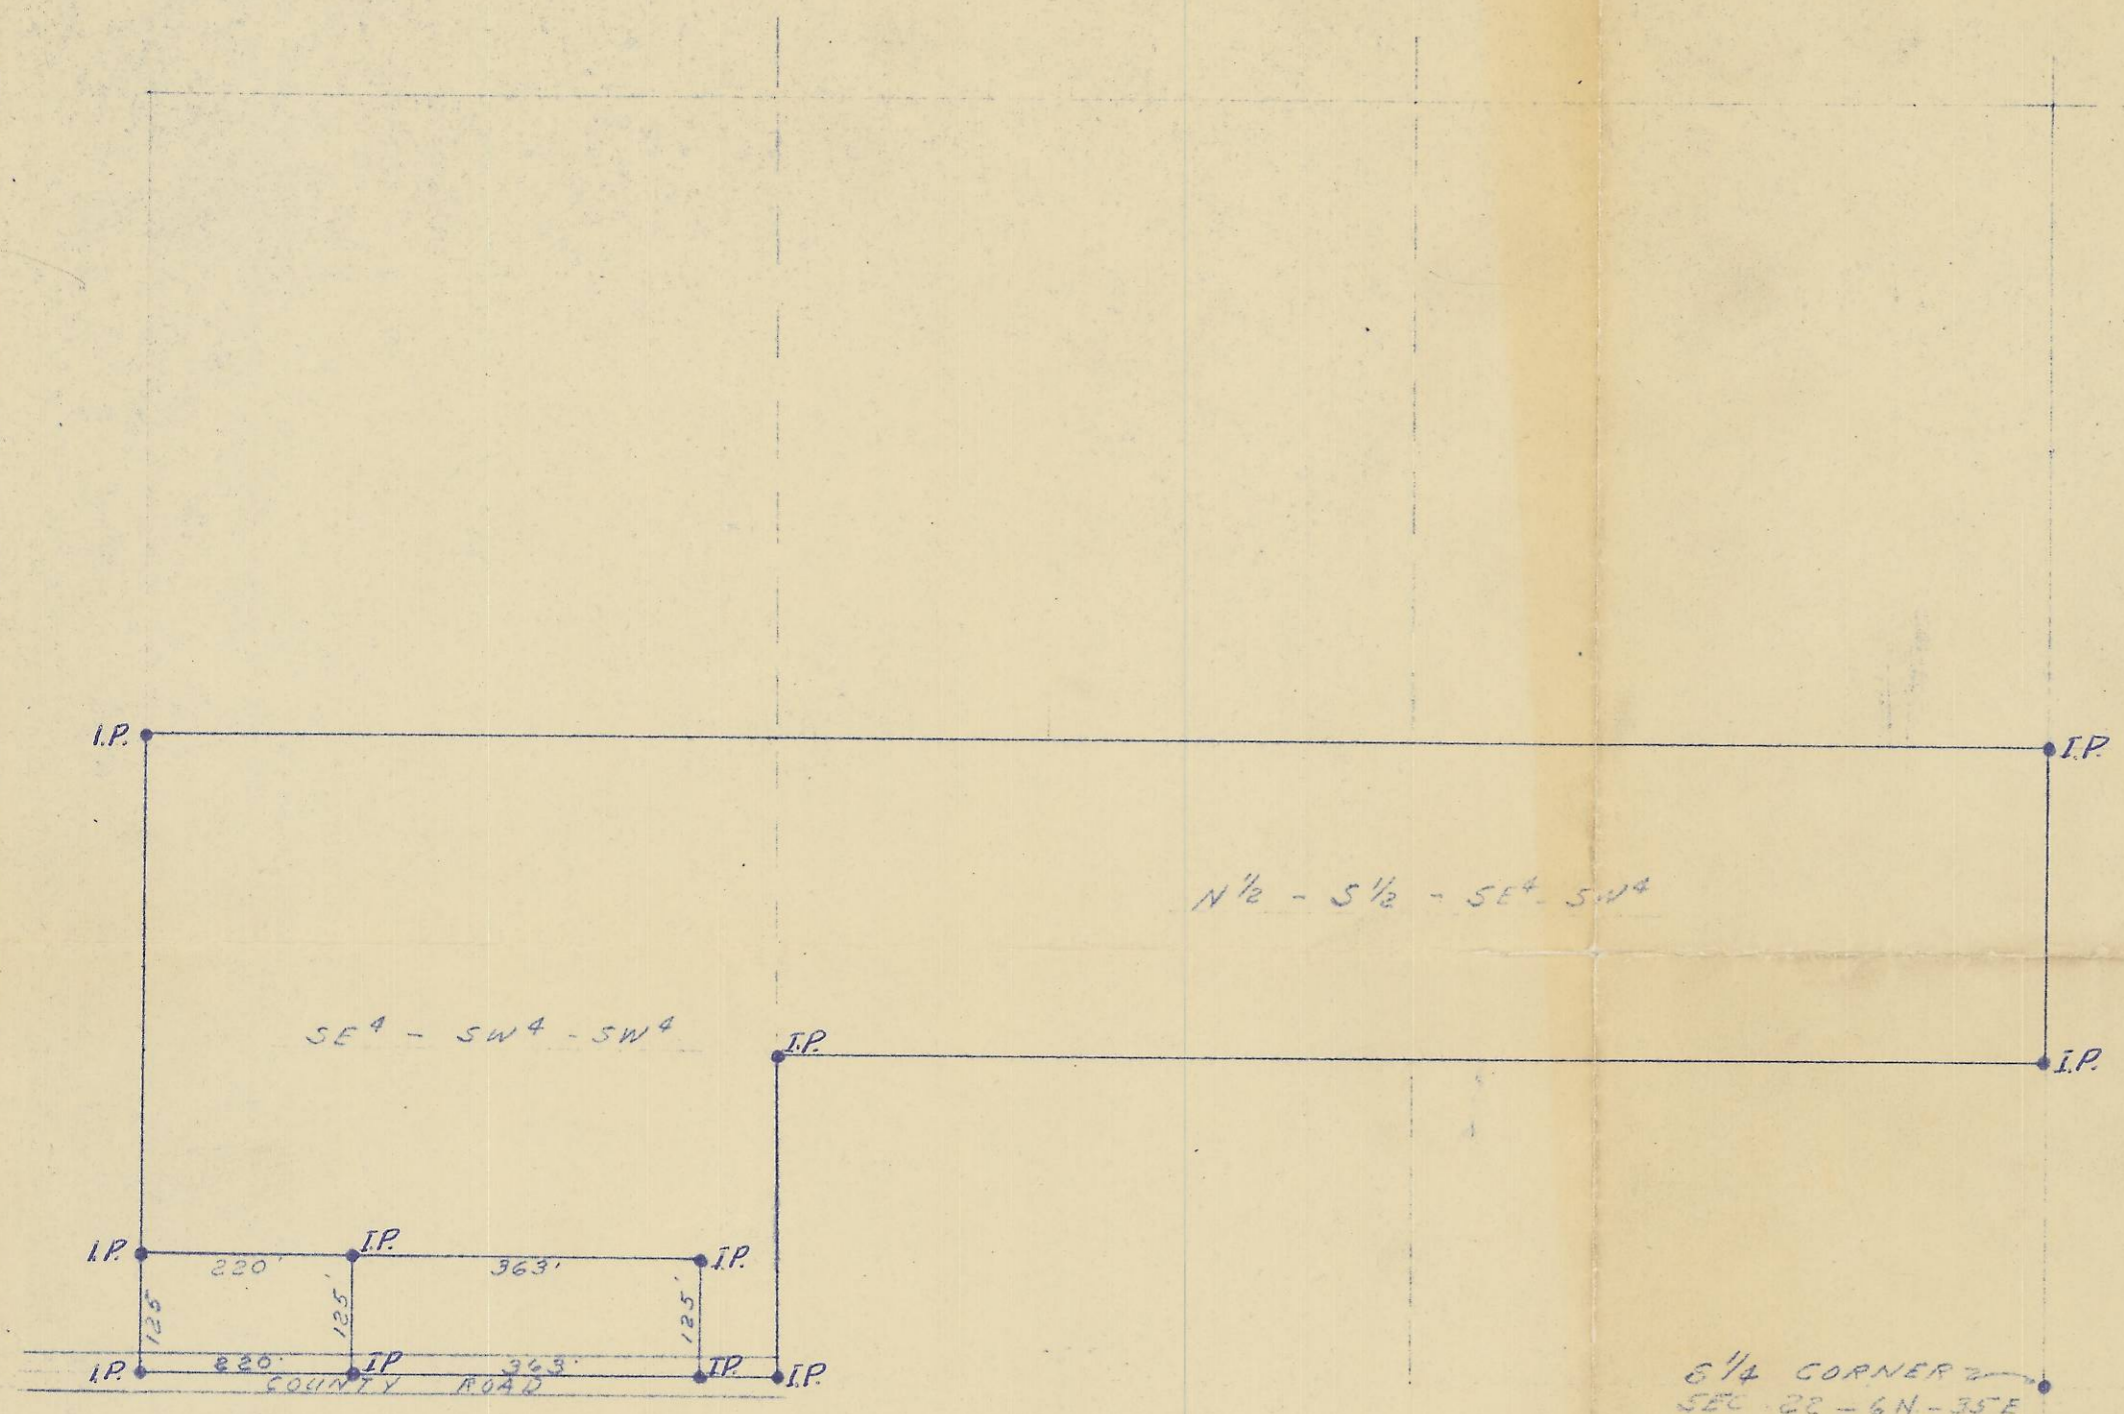

SCALE 1" = 200'
• IRON PINS AT CORNERS

REGISTERED
OREGON
LAND SURVEYOR

G. M. Newbill

MAY 6, 1940
G. M. NEWBILL
255

G. M. NEWBILL	
LICENSED LAND SURVEYOR	
17 N. Second	Walla Walla, Wash. Phone 4170
Surveys	A SURVEY
Descriptions	FOR SAM PRYHOROCKI
Sub Divisions	SECTION 22, TWP 6 NORTH, RANGE 35
Date	3-24-56
Drawn By	DTD
Checked By	GMN
No.	1768

1071