


Q-1003-AX

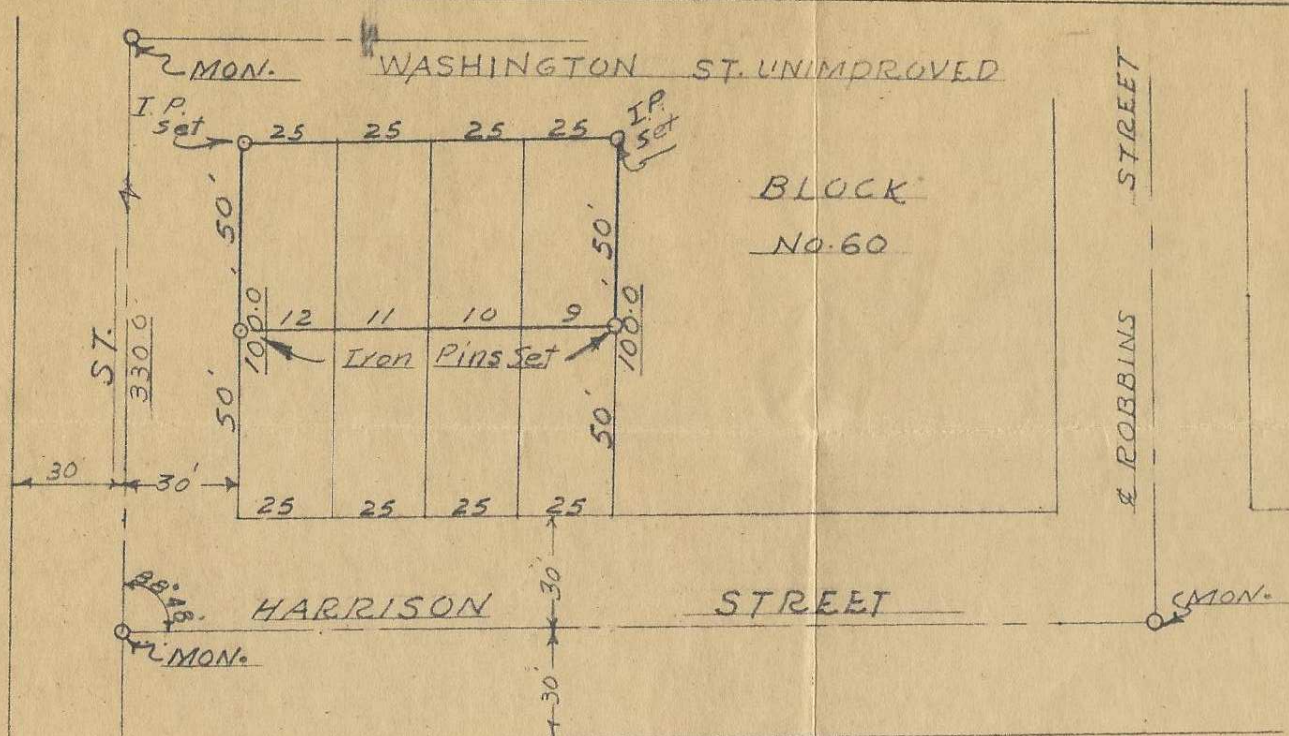

DEPOT ST.

ST. 330.0

30' 30'

BB&B MON.

HARRISON STREET

STREET

ROBBINS STREET

BLOCK NO. 60

SCALE 1" = 50.0'

Filed May 21-1949

NE (2)

C. H. Storms & Associates

CONSULTING ENGINEERS — ARCHITECTS

304 DENNY BUILDING TELEPHONE 4170 WALLA WALLA, WASH.

- Mechanical
- Structural
- Hydraulic
- Sanitary
- Designs
- Land Surveys
- House Plans
- Blue Prints
- Estimates

A SURVEY FOR  
GEORGE BELLER  
 NORTH 1/2 LOTS 9, 10, 11 & 12  
 BLOCK NO. 60  
 FREEWATER — OREGON

Date MAY 18 49  
 Drawn By BERT  
 Checked By YL

864  
 SHEET OF