

SURVEY FOR LLOYD A. or RUTH LOUISE PLATT  
 Lots 1,2,3,4, in Blk 34, Coe's 1st Add'n  
 to Stanfield in Umatilla Co., Oregon

May 22, 1960

Scale 1" = 200'

9-1021-AX




COE

FURNISH

TAFT

PAGE

TUTTLE

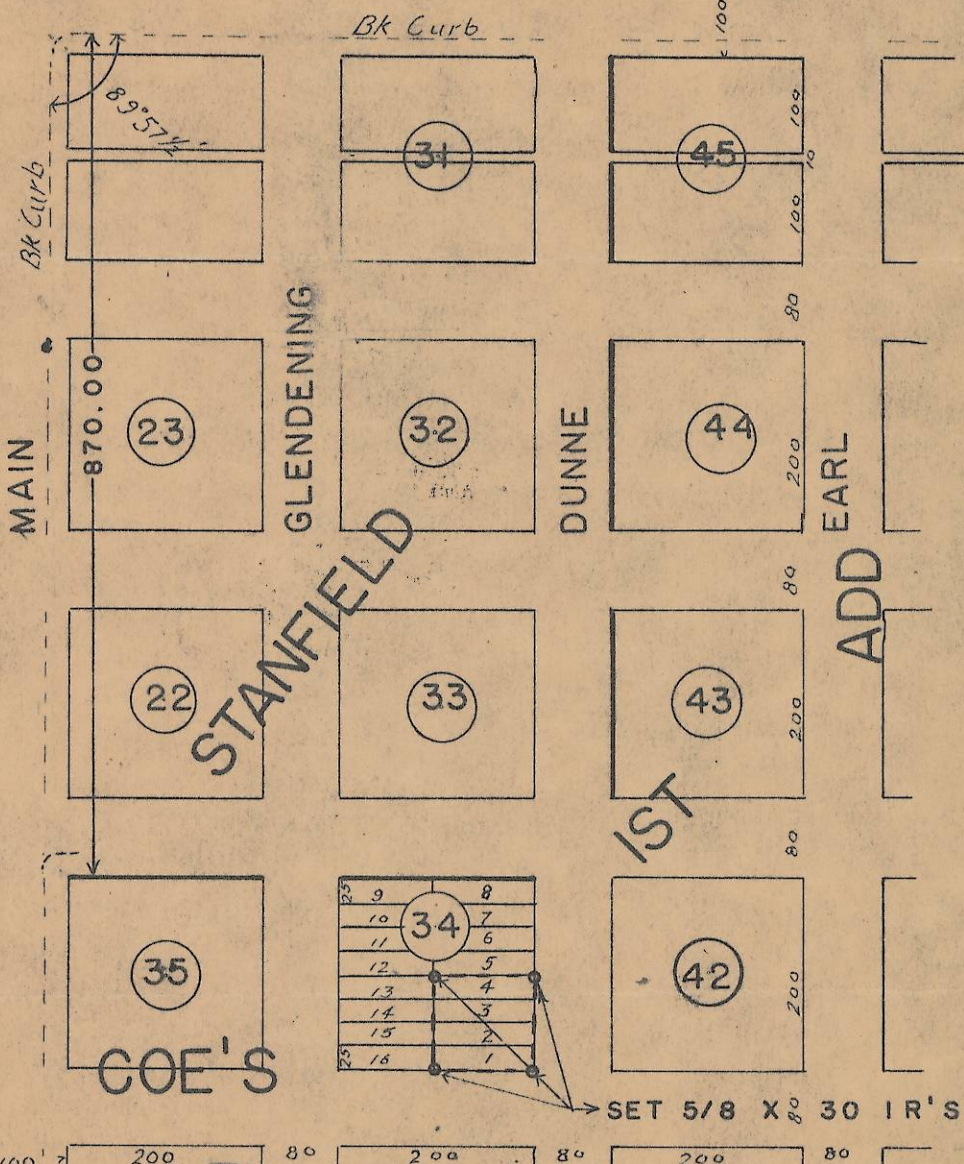

REGISTERED  
 OREGON  
 LAND SURVEYOR  
*Donald C. Kyle*  
 OCTOBER 24, 1958  
 DONALD C. KYLE  
 456

0007

540