


Q - 1065-Ax

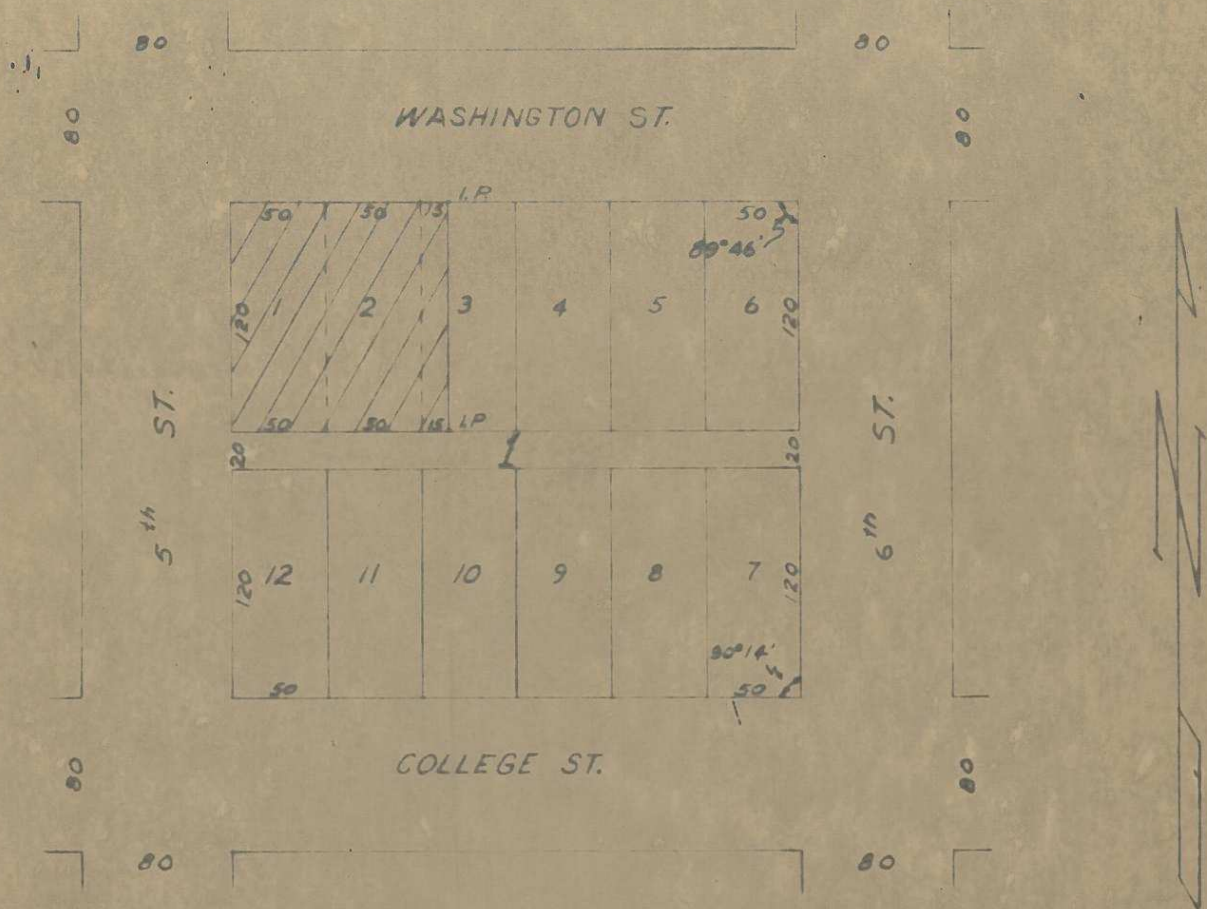

STATE OF OREGON
 WADE CO. HARRIS
 WAYNE O. HARRIS
 345

HAYES AND HARRIS			
SURVEY FOR JACK TILLMAN			
LOTS 1 and 2 and WEST 15' LOT 3 BLOCK 1 KIRK'S 4th. ADDITION ATHENA, OREGON			
SCALE	DATE	DRW. BY	DRW. No.
1" - 100'	6-5-58	aby	