


• 1/2" IRON PIN SET

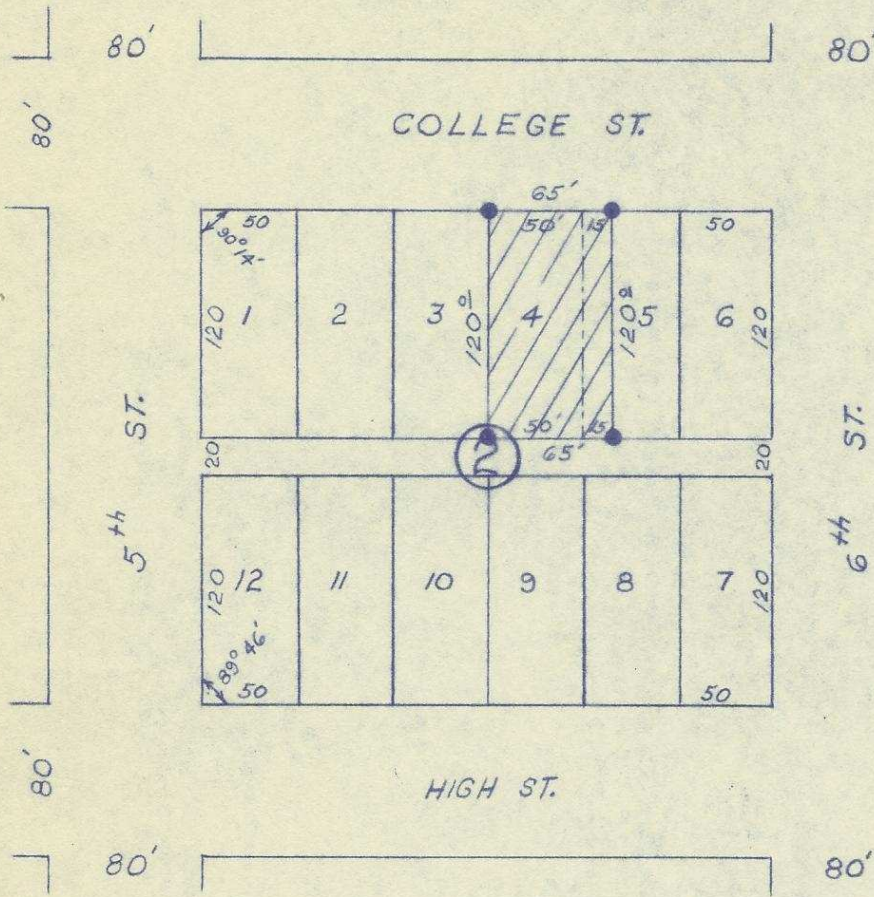

REGISTERED
OREGON
LAND SURVEYOR
Wayne O. Harris
MAY 6, 1955
WAYNE O. HARRIS
346

HAYES AND HARRIS

SURVEY FOR
DOROTHY BUSH

LOT 4 & WEST 15' OF LOT 5, BLK. 2
KIRK'S 4TH ADDITION, ATHENA, OREGON

SCALE	DATE	DRN. BY	DRNG. NO.
1" = 100'	11/13/63	JEB	63-185

9-1077-Ax