

Field Notes

By: Vernon B. Tenneson & Assoc


For: Phil Jamisen

At: Pilot Rock, Oregon


Party: Wallulis & Robertson

Date: August 22, 1956

NESE 17

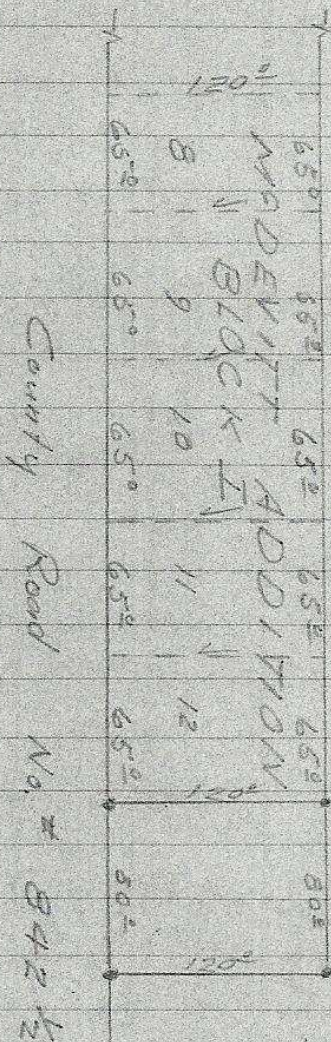

Legend
• pins set in field

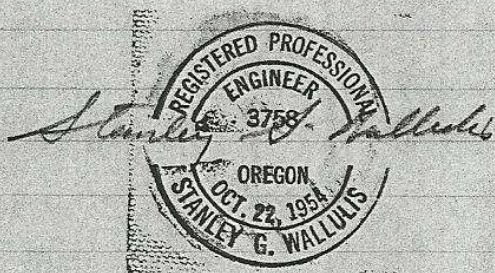

X-1246-A