


Legend

- Pipes found ----- ●
- Pipes set ----- ○



Prepared for Anthony Cavanagh.

Deed Records: BK 171, pg 291; BK 171, pg 551; BK 197, pg 367.

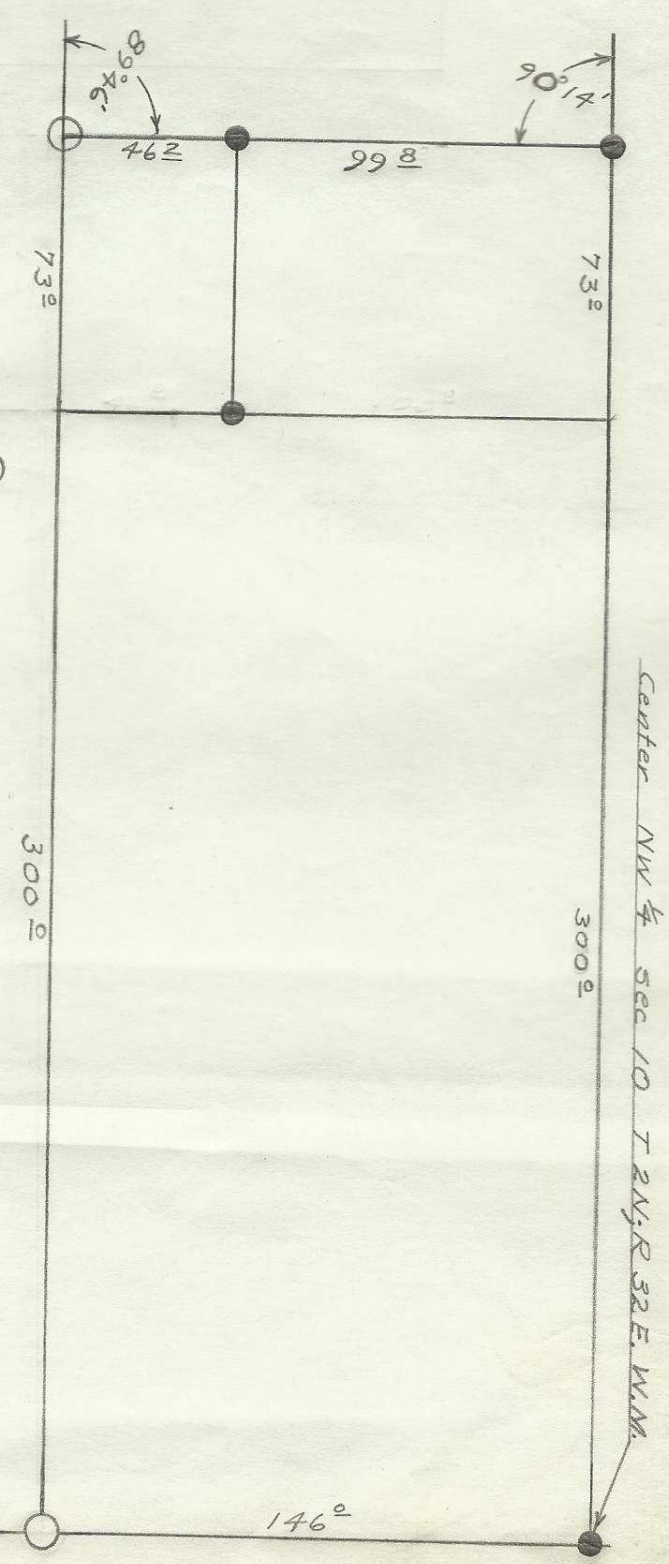

SCALE: 1" = 50'	DATE: 1-3-55
WALL AND TENNESON Engineers	
Pendleton	Oregon

Q-1295-Ax

SE