


NW 1/4 NE 16

VERNON B. TENNESON & ASSOCIATES

June 6, 1956

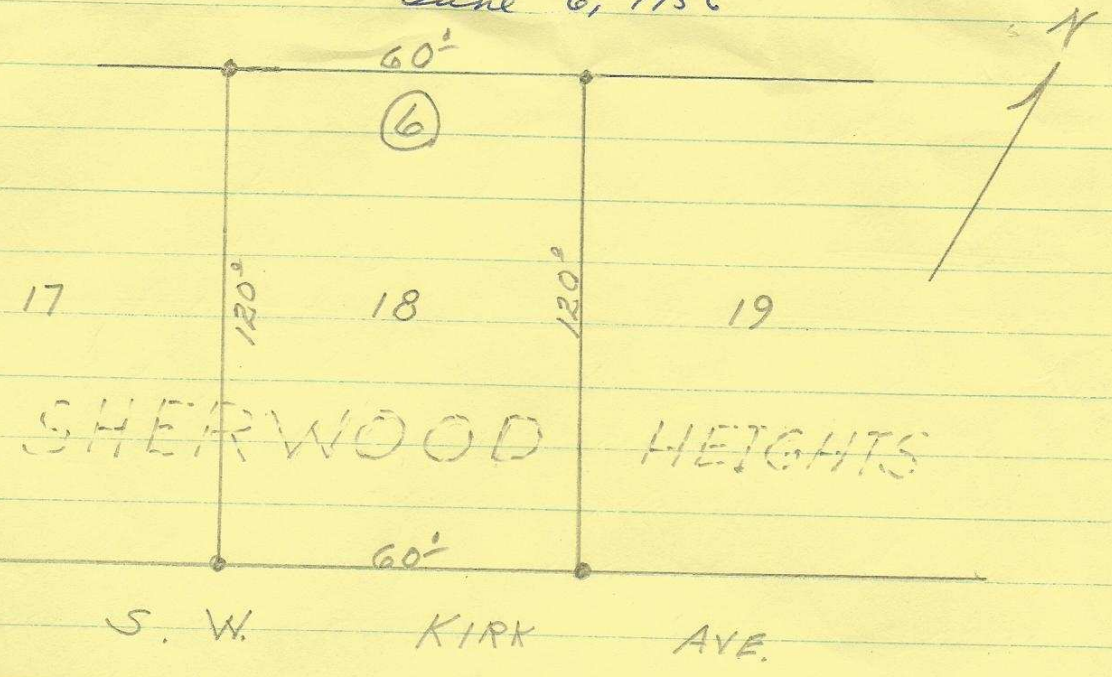

• 1/2" x 24" IRON PIN  
249

16 AB

