618

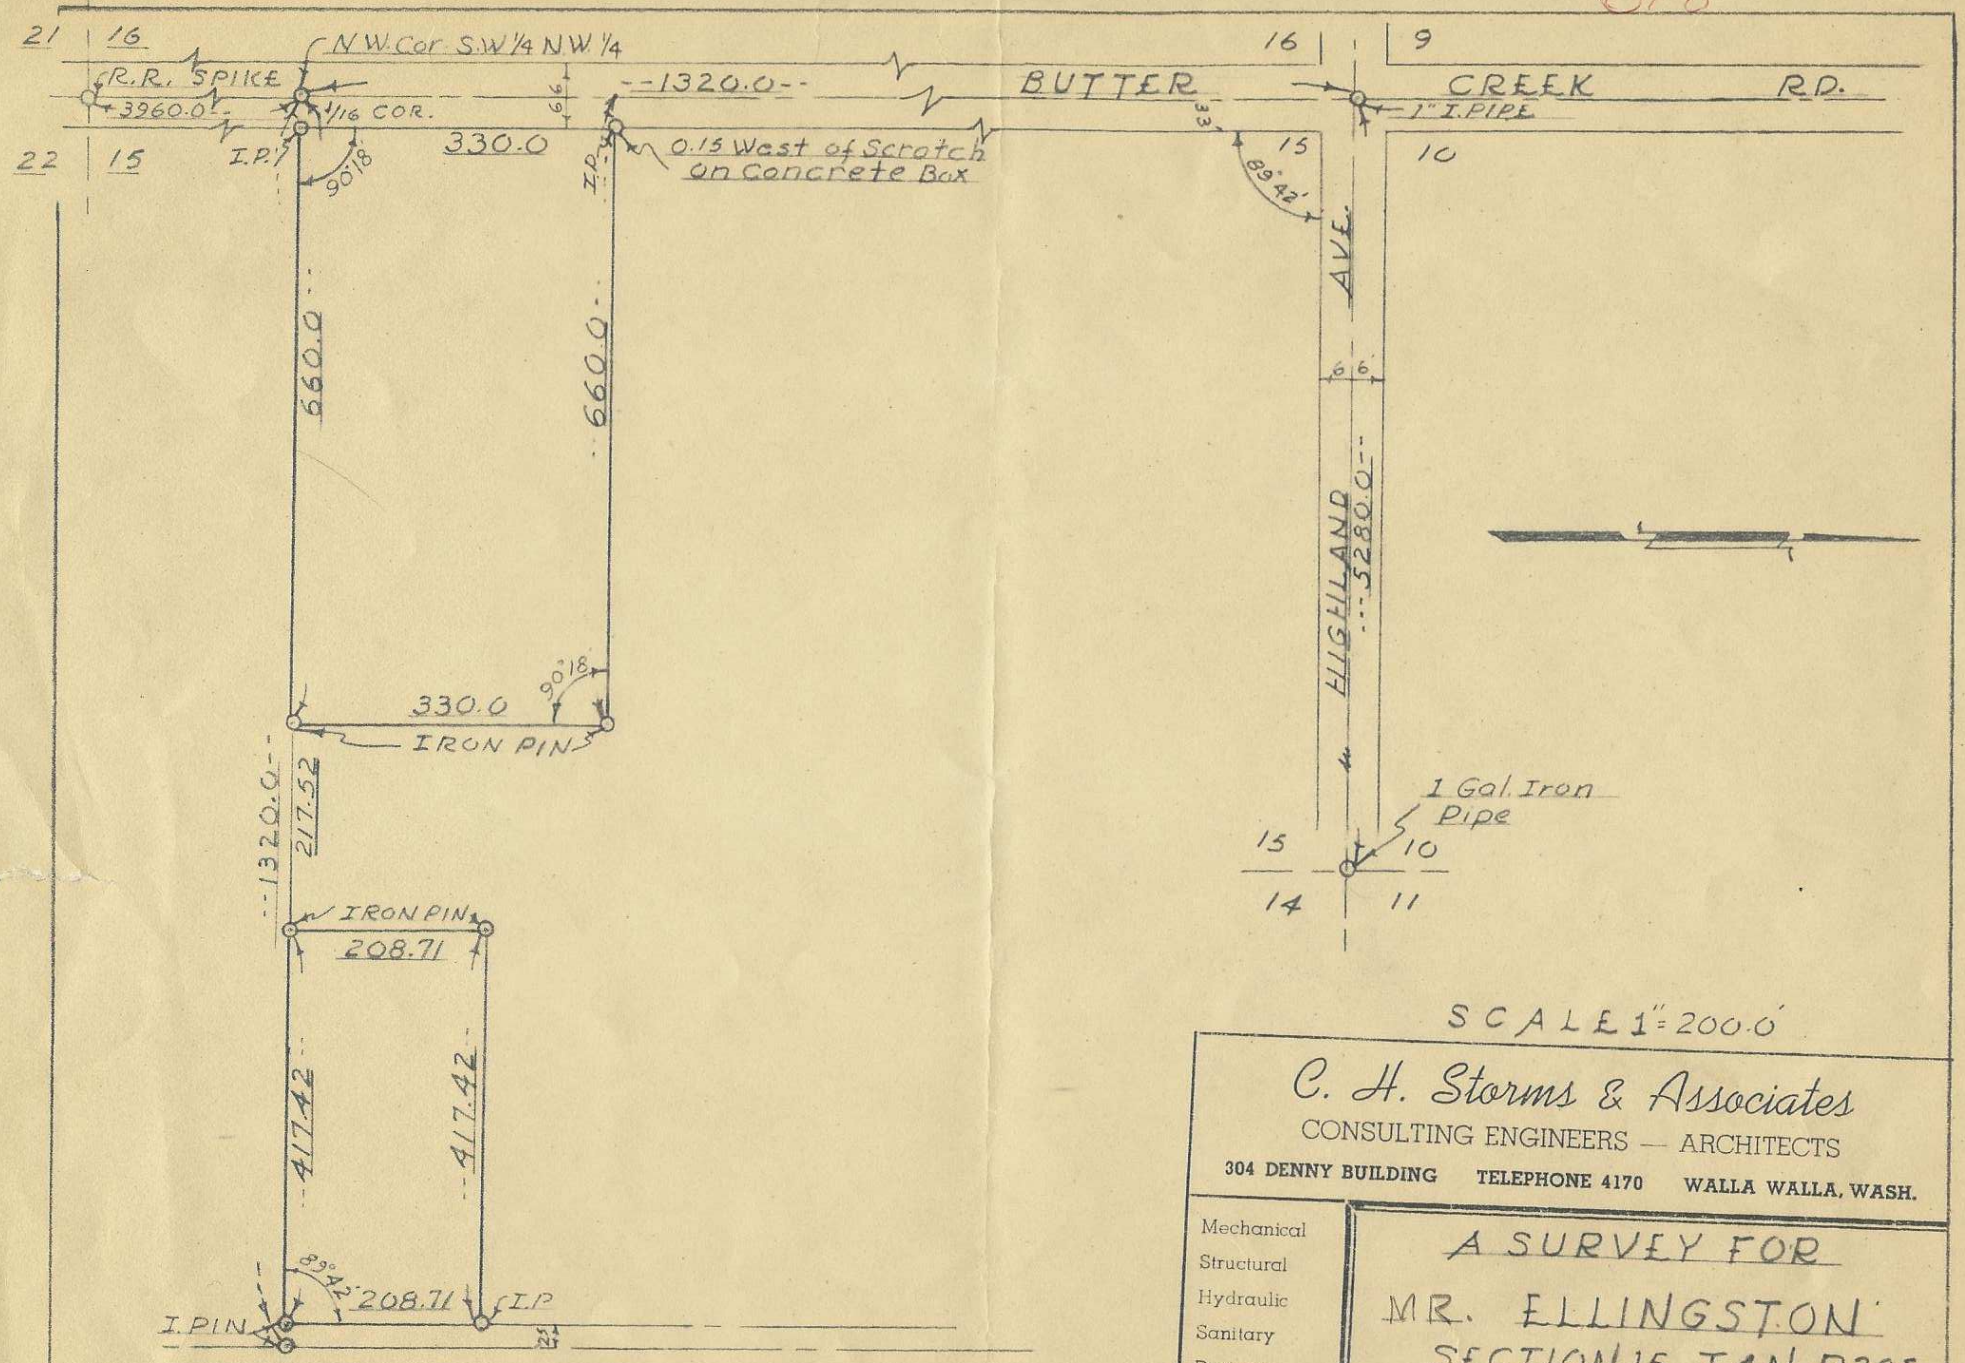

SCALE 1" = 200.0'

C. H. Storms & Associates
CONSULTING ENGINEERS — ARCHITECTS
304 DENNY BUILDING TELEPHONE 4170 WALLA WALLA, WASH.

Mechanical
Structural
Hydraulic
Sanitary
Designs
Land Surveys
House Plans
Blue Prints
Estimates

A SURVEY FOR
MR. ELLINGSTON
SECTION 15 T4N. R28E.
HERMISTON N.W.¼ N.W.¼ OREGON

Date FEB. 4 1949
Drawn By B.F.C.
Checked By G.M.N.

749

SHEET OF

Q-1338-Ax

Q-1338-A1

no negs available