

Nye's Hill Cadd.

STANLEY G. WALLULIS  
CONSULTING ENGINEER  
P.O. BOX 91  
PENDLETON, OREGON

SUBDIVISION OF NORTHWEST QUARTER

SECTION 10, TOWNSHIP 4 NORTH, RANGE 28 EAST


We began our survey by searching for the section and quarter corners around the exterior of section 10. We found all the corners with the exception of the South quarter corner of said Section 10 and have noted same on the accompanying map. We then established a temporary corner for the South quarter corner of Section 10 equidistant from the Southeast and Southwest corners.

We then established temporarily the center quarter corner of said section from information on file of Hillview Addition to the City of Hermiston. This temporary corner was established from the initial point of said Addition.

We checked the location of the temporary center quarter corner from the East quarter corner to the West quarter corner of Section 10 and found this to be on a true line. We then prolonged line from our temporary center quarter corner from the North quarter corner in a southerly direction to the temporary set South quarter corner. We missed the South quarter corner for alignment by .06 of a foot.

We then amended the position of the center quarter corner .03 of a foot and set pins as noted on the accompanying map.

*Stanley G. Wallulis*  
Stanley G. Wallulis

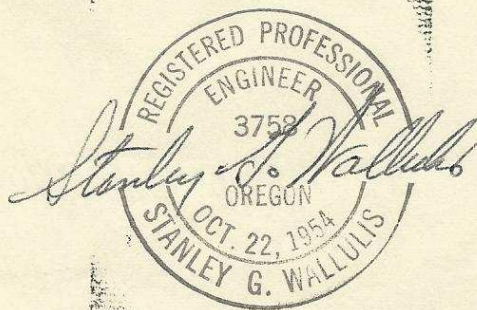

Aug 7, 1962

Q-1360-AY