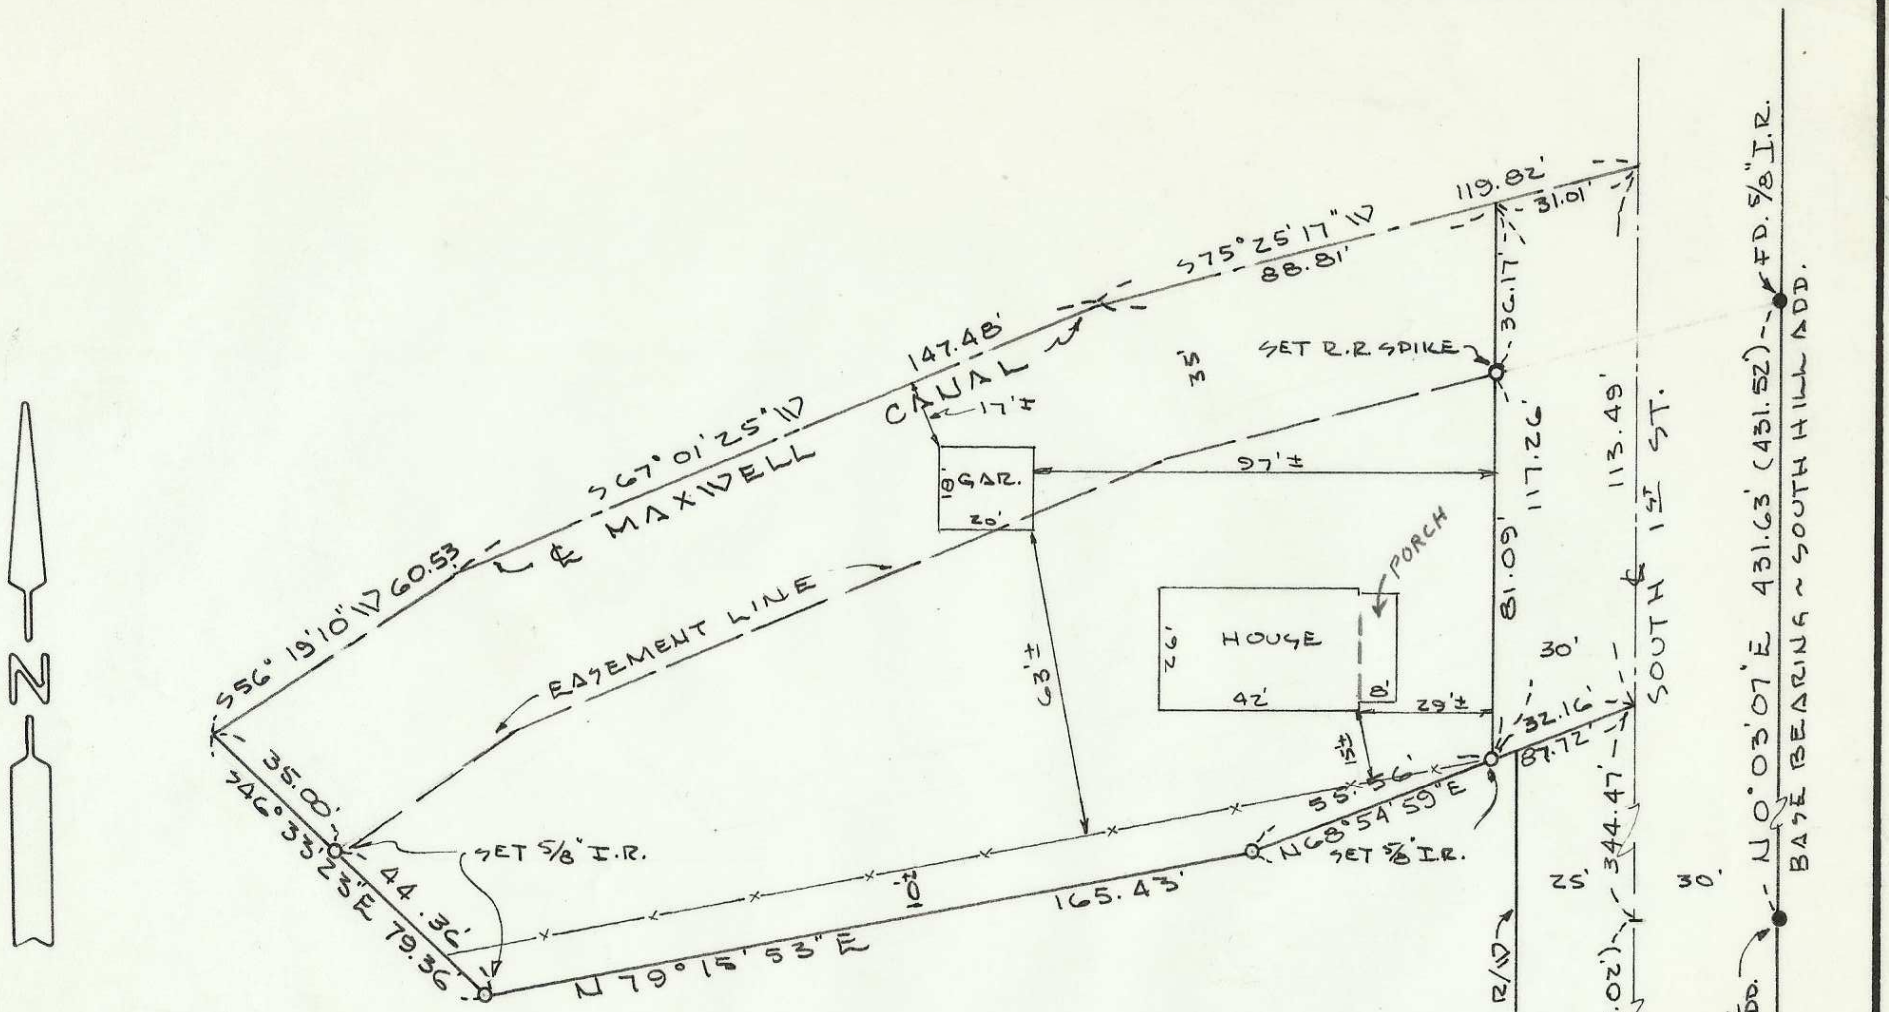


REGISTERED PROFESSIONAL LAND SURVEYOR

G. Dennis Edwards

OREGON
JULY 16, 1971
G. DENNIS EDWARDS
951

SURVEY FOR: KEN KAMERRER

LOCATION: SE1/4 NE1/4 SEC. 15, T4N, R28E, W.M.
UMATILLA COUNTY, OREGON.

● MONUMENTS FOUND
○ MONUMENTS SET
(000) RECORD

JOB NO. S8104068
DATE: 4/27/81
SCALE: 1" = 40'

EDWARDS SURVEYING P.O. BOX 763 HERMISTON, OREGON 567-3336.

RECEIVED BY
Umatilla County Surveyor
Date 6-81
Rec'd by BLS
No. S-76-A

S-76-A