


SECTION MONUMENTATION

SECTION 29, T5N., R29E., W.M.

UMATILLA CO., OREGON

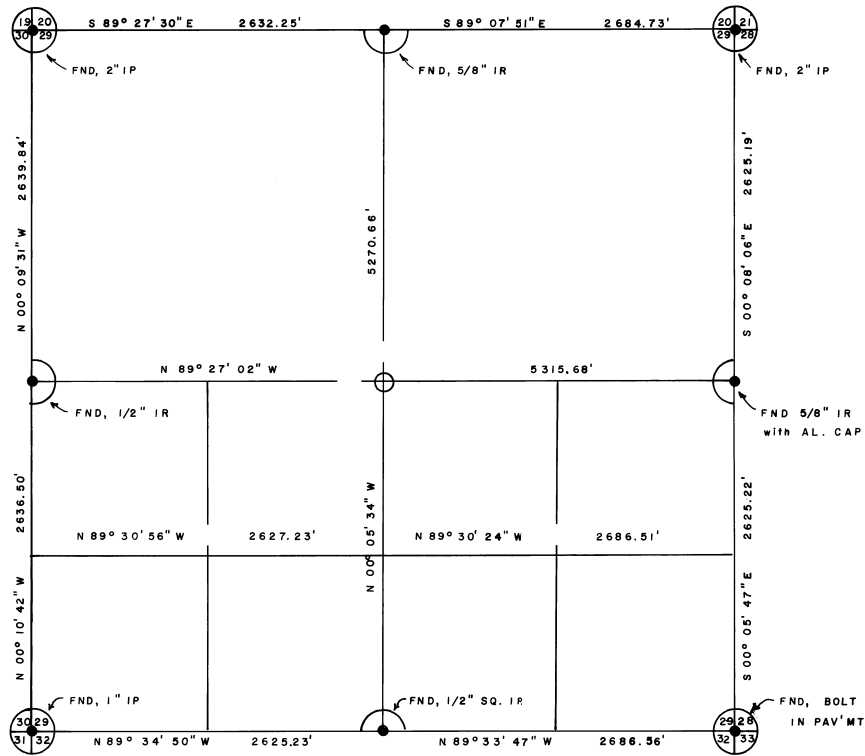

SCALE - NONE

BASIS OF BEARING — SAME AS,
DE MOSS HOMESTEAD SUBDIVISION
RECORDED PLAT BK 12, PG 16.

REGISTERED
PROFESSIONAL
LAND SURVEYOR

OREGON
SEPT. 23, 1919
THOMAS F. LAMER
1242

<i>Section Monumentation</i>			
TE	TELEK ENGINEERING	DATE	SCALE
	540 SW 11TH STREET	FEB. 1982	
	HERMISTON, OREGON	REVISIONS	SHEET
	97838	DRAWN BY	1