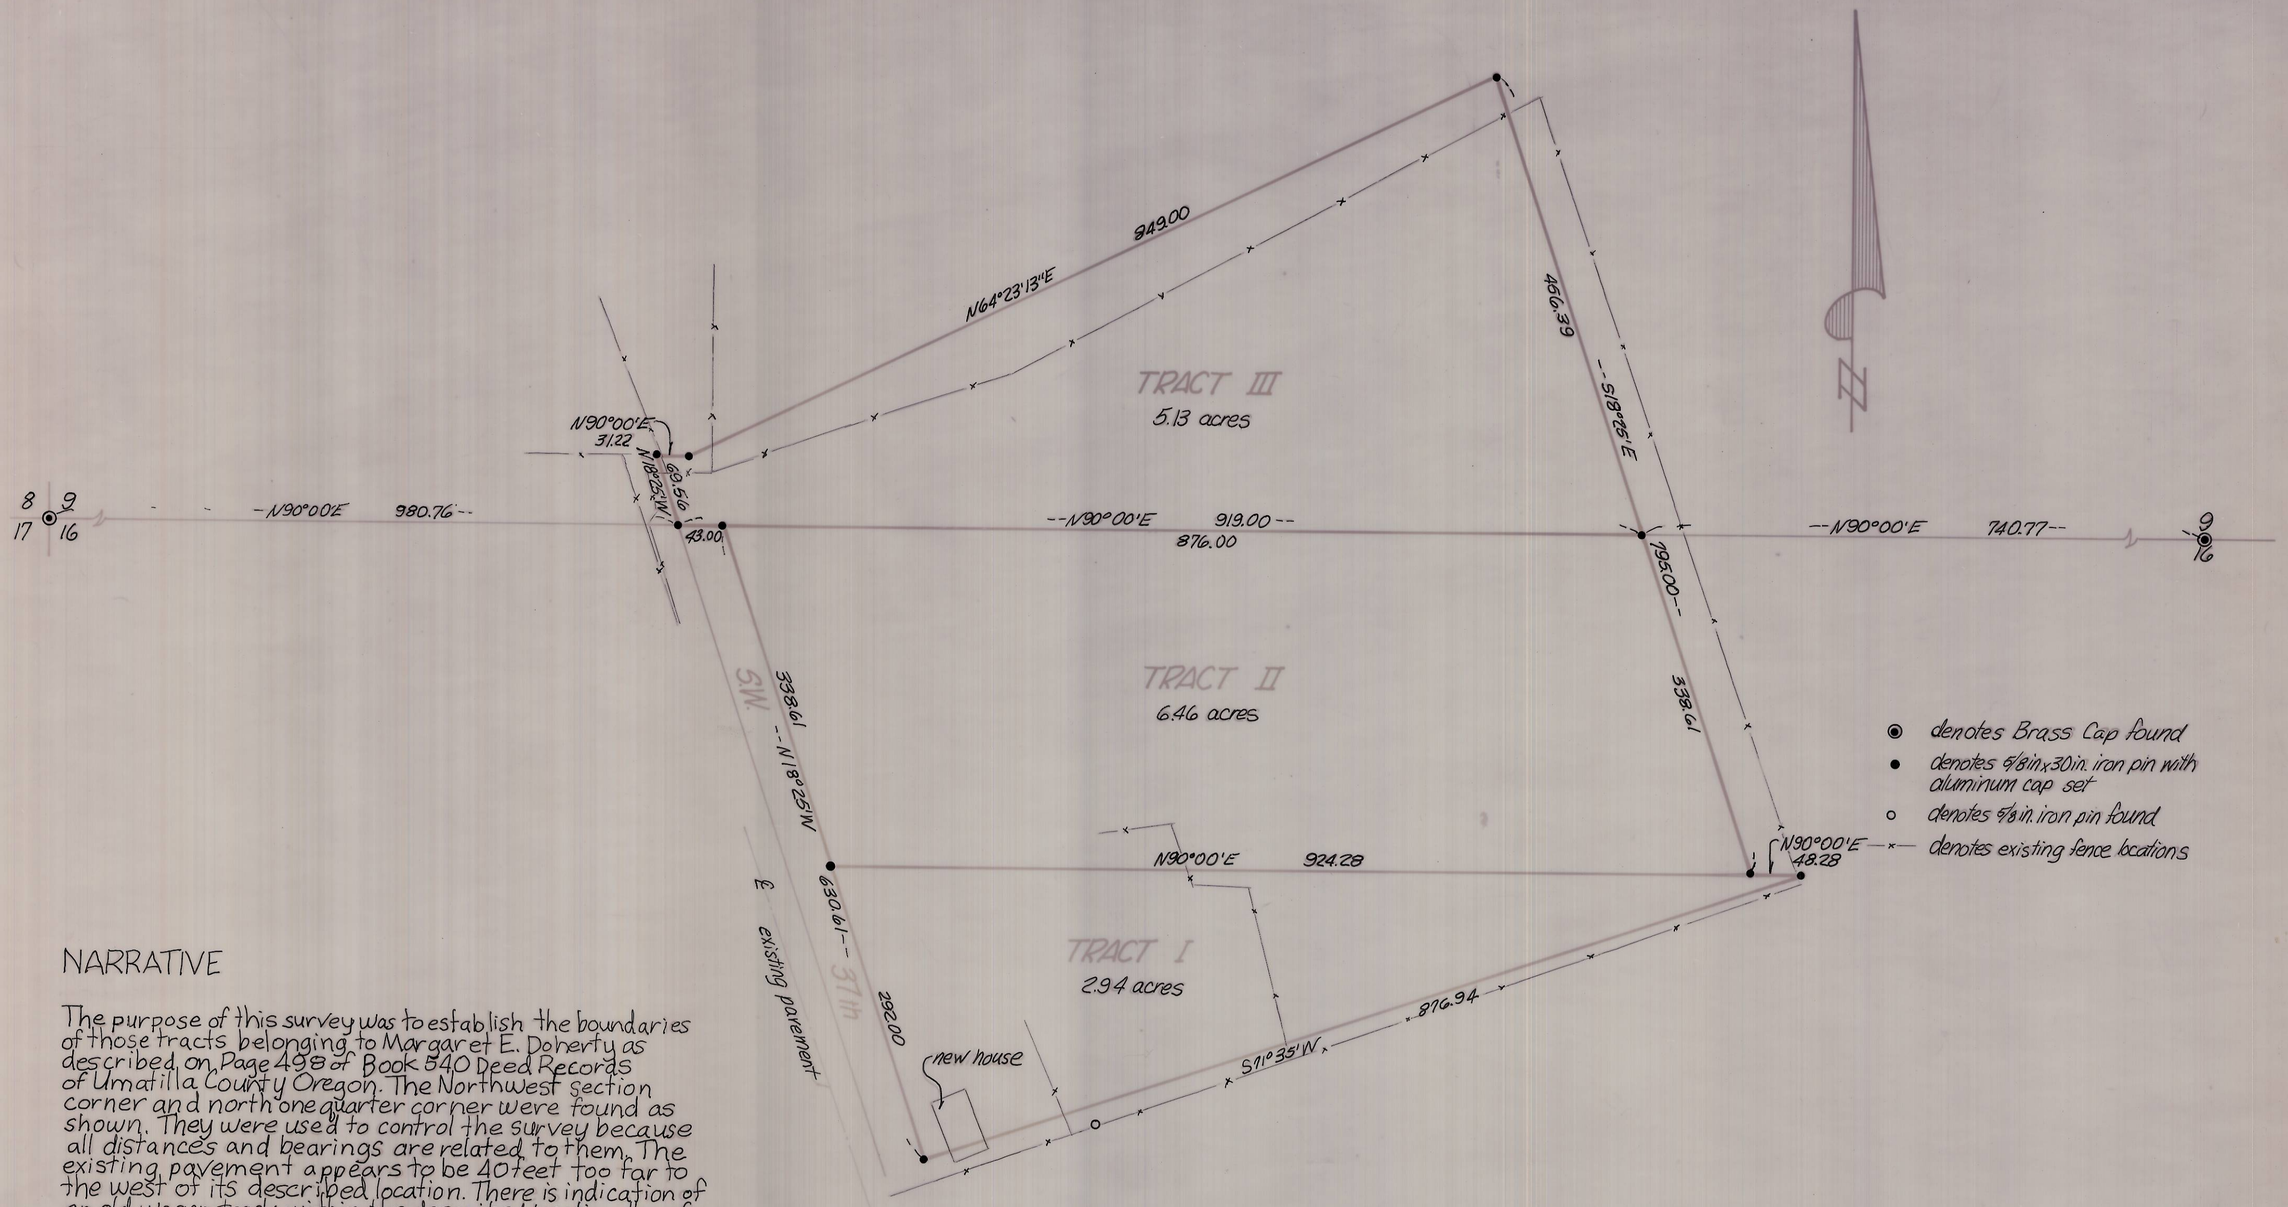

NARRATIVE

The purpose of this survey was to establish the boundaries of those tracts belonging to Margaret E. Doherty as described on Page 498 of Book 540 Deed Records of Umatilla County Oregon. The Northwest section corner and north one quarter corner were found as shown. They were used to control the survey because all distances and bearings are related to them. The existing pavement appears to be 40 feet too far to the west of its described location. There is indication of an old wagon track within the described location therefore no justification could be found for the location being anywhere other than as described. The fence line on the south side of the house has been in place for more than twenty years and should be held as the property line. A pin was found as shown in this fence, but no record of its origins can be found. Bearings are based on the aforementioned legal description.

RECEIVED BY
Umatilla County Surveyor
Date 2-15-83
Rec'd By BKC
No. 83-12-B

REGISTERED PROFESSIONAL LAND SURVEYOR
David H Klein
OREGON

KRUMBEIN ENGINEERING CO.
ENGINEERS – SURVEYORS – PLANNERS
221 S. Main, Pendleton, Oregon

Survey for
DOHERTY
located in Sections 9 & 16, T2N. R32E. W.M.

SCALE	1" = 100'
DATE	Nov. 30, 1982
DRN. BY	MH
CKD. BY	DHK
DRNG. NO.	82-40C

Job No. 82-131