

**PROPERTY DESCRIPTION  
A PART OF ALLOTMENT UM 129-B**





**NARRATIVE OF SURVEY**

THE PURPOSE OF THIS SURVEY WAS TO LOCATE AND MONUMENT THE BOUNDARIES OF A 1.00 ACRE NET AREA HOMESITE FOR THE UMATILLA RESERVATION HOUSING AUTHORITY. THE ZONING AUTHORITY FOR APPROVAL OF ANY LAND DIVISION IS THE DEPARTMENT OF NATURAL RESOURCES OF THE CONFEDERATED TRIBES OF THE UMATILLA INDIAN RESERVATION.





RIGHT-OF-WAY WIDTH FOR THE COUNTY ROAD WAS FURNISHED BY THE UMATILLA COUNTY ROAD DEPARTMENT.

THIS SURVEY WAS MADE WITH A 2 PERSON CREW USING A LIETZ SET 3-B TOTAL STATION AND LIETZ SDR 22 ELECTRONIC FIELD BOOK.

**GENERAL NOTES:**

1. BUILDING SETBACKS ARE 20 FEET.
2. OVERHEAD POWER IS AVAILABLE SOUTH OF THE COUNTY ROAD AS SHOWN ON THIS MAP.
3. TELEPHONE SERVICE IS NOT AVAILABLE IN THIS AREA.

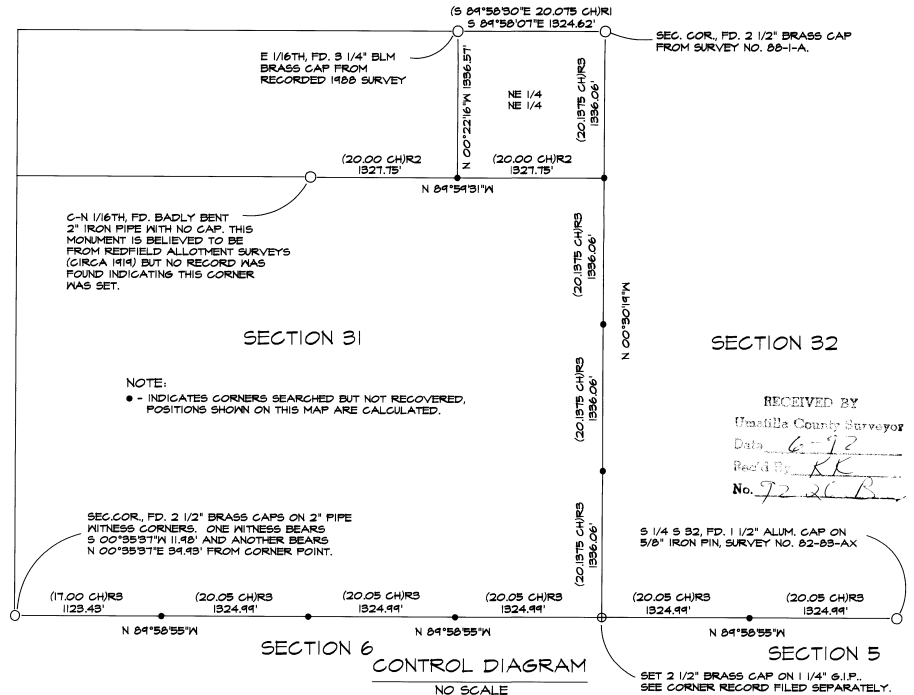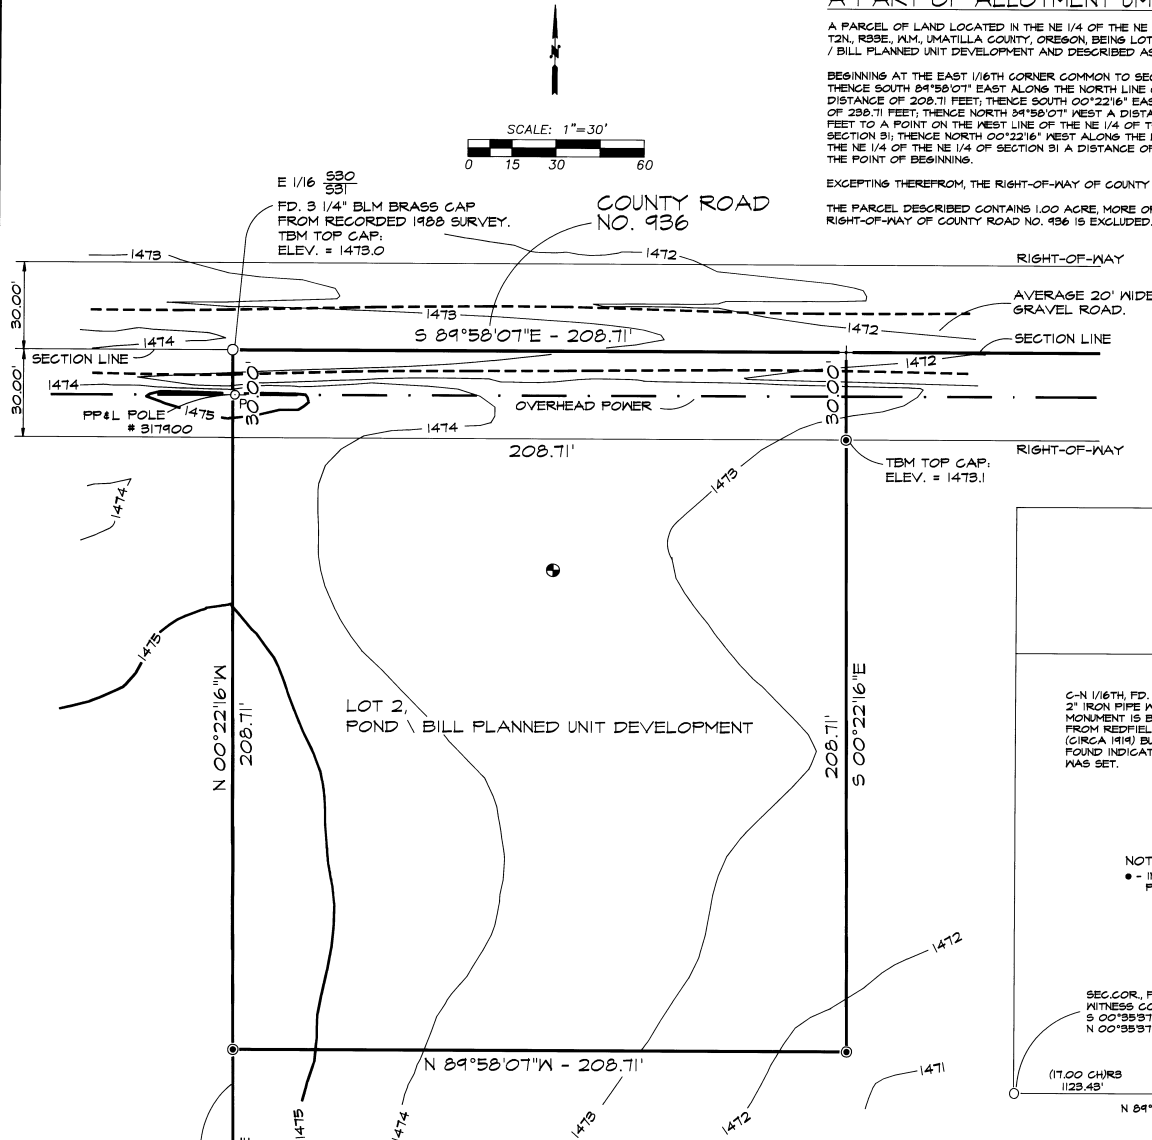

**LEGEND**

- - MONUMENTS FOUND AS NOTED.
- - FD. 5/8" IRON PIN WITH 1 1/2" YELLOW PLASTIC CAP MARKED "W.R. WELLS, PLS1106, PER SURVEY NO. 92-28-B.
- (XOX)R1 - RECORD FROM 1988 RECORDED BLM SURVEY.
- (XOX)R2 - RECORD FROM CURRIN AND NOLAND ALLOTMENT SURVEY (GLO, 1887).
- (XOX)R3 - RECORD FROM C.E. REDFIELD SURVEYS - CIRCA 1919.
- - LOCATION OF GEOTECHNICAL AUGER HOLE.

REGISTERED PROFESSIONAL LAND SURVEYOR  
*William R. Wells*  
OREGON  
JULY 22, 1977  
WILLIAM R. WELLS  
1106

WILLIAM R. WELLS, PLS  
357 N.E. HWY. 11  
P.O. BOX 1696  
PENDLETON, OR 97801  
PHONE: (503) 276-6362

PROJECT:  
UMATILLA RESERVATION HOUSING AUTHORITY  
PROJECT: 12010  
PARTICIPANT:  
ROBERT BILL

DATE: 12-18-91 DR. BY: MEQ  
CK. BY: WRW NO: 91-114

SITE NO.: 13  
DWELLING TYPE: 3 BEDROOM

RECEIVED BY  
Umatilla County Surveyor  
