


NARRATIVE

PURPOSE OF THIS SURVEY WAS TO ESTABLISH THE BOUNDARIES OF LOTS 1 AND 2, BLOCK 1 OF KIRKS THIRD ADDITION TO THE CITY OF ATHENA. THIS WAS DONE AT THE REQUEST OF MARSHALL MILBY. A SURVEY HAD BEEN DONE EARLIER THIS YEAR OF LOT 10 AND A PORTION OF LOT 9 IN SAID BLOCK 1, C.S. NO. 93-45B. TIES WERE MADE TO POINTS FOUND AND SET DURING THAT SURVEY AND I SET THE PINS SHOWN FROM THOSE POINTS USING THE PLAT DISTANCES ADJUSTED AS NOTED FOR ADDITIONAL LENGTH BETWEEN THE STREET MONUMENTS, THE FOUND POINTS WERE 5/8" IRON REBAR WITH RED PLASTIC CAPS MARKED ORLS 2166 EXCEPT AS NOTED OTHERWISE, THE POINT MARKED 3/4" IS A 3/4" IRON REBAR THAT LIES SOUTH 0.10' FROM THE TRUE POSITION OF THE CORNER. THE REBAR THAT I SET AGREE VERY WELL WITH THE EXISTING IMPROVEMENTS.

THE BASIS OF BEARING IS THE CENTERLINE OF MAIN STREET BEARING N 88 DEGREES 58'08" EAST, WHICH IS A OREGON STATE GRID BEARING (THETA 1 DEGREE 26'21").

- ▲ INDICATES POINTS FOUND AS NOTED ON DRAWING AND IN NARRATIVE
- INDICATES SET 5/8" X 30" IRON REBAR W/ ALLUM CAP STAMPED KEL - PLS 933

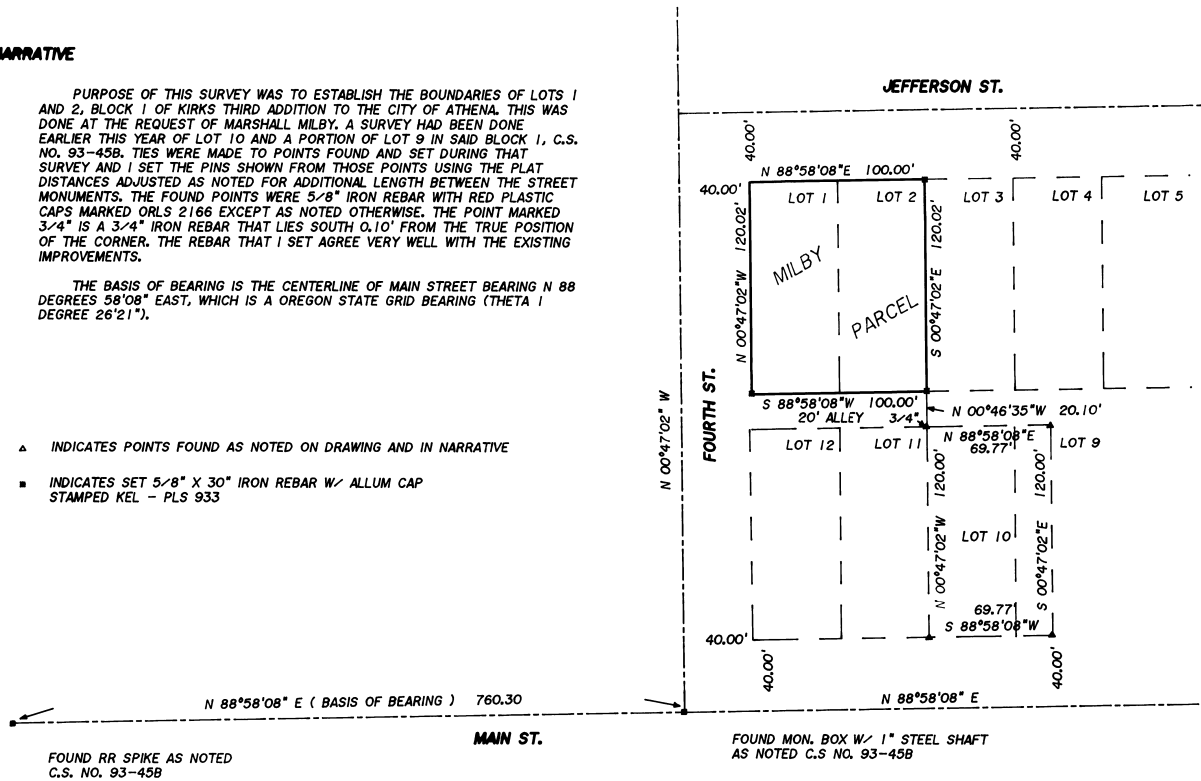

KRUMBEIN ENGINEERING LTD. ENGINEERS - SURVEYORS - PLANNERS 361 S.E. Second Peninsula, Oregon	Scale 1"=50'	Dwn. By H.D.	Dwg. No. 5300C	Revision 1
	Date 9-28-99	Chf. By DMK	Job No. 9334	Revision 2
SURVEY MARSHAL MILBY SW 1/4, NE 1/4 SEC 19, T4N, R35E		REGISTERED PROFESSIONAL LAND SURVEYOR <i>David H. Krumbein</i> OREGON JULY 15, 1980 DWG. H. K. 133		RECEIVED BY Umatilla County Surveyor Date: 11-93 Rec'd by: KR No.: 93-84-B