

- ✚ Found Section Corner as Noted
- ⊕ Found Quarter Section Corner as Noted
- Set 5/8"x24" Rebar w/ Plastic Cap "OR 2166LS" per R21
- Found Monument as Noted [Record per Reference Doc #]

Narrative of Survey

A survey to monument Lot 6, of Block 12 of Kirk's Second Addition to the City of Athena.

Survey commenced January 10, 2000. Instrument used was a Topcon GTS2-06. Four angles were measured by repetition for the control traverse.

Bearings are Grid, Oregon Coordinate System of 1983, North Zone, and are based on observations from Athena NGS, theta < +1' 26" 23".

As was noted Map 90-011-A, and subsequent surveys, the distance from Main Street to the North line of Section 19 is 3.72 feet longer than the plotted dimensions, which are vague.


The method used to calculate these dimensions was: to set North-South streets parallel to monumented Fourth Street; to set East-West Streets parallel to Main Street; using the dimensions of Railroad Addition, to set the North Lines of Railroad Addition to the currently accepted positions of section corners to the East and West; and to evenly proportion the excess distance between Main Street and Washington Street.

REGISTERED PROFESSIONAL LAND SURVEYOR


Dwight M. Bartleson

OREGON JULY 26, 1986 DWIGHT M. BARTLESON 02166LS

Renews: Dec. 31, 2001

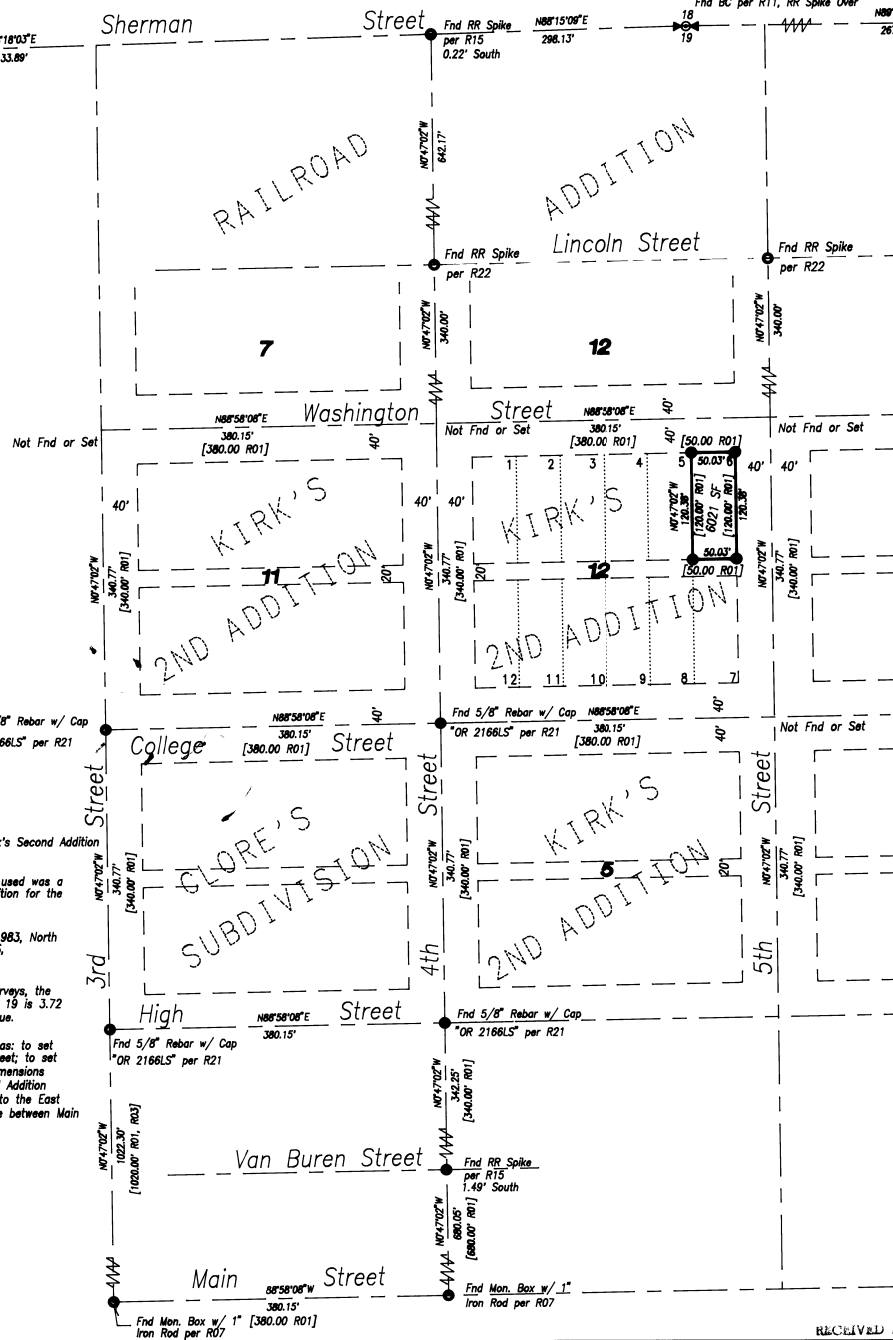

- Description**
- Lot 6 of Block 12 of Kirk's Second Addition to the Town of Centerville (Athena).
- Reference Documents**
- R01 Deed Book "D" at pages 131 & 227 & Plat Book 2 at page 4, Records of Umatilla County - Original Town of Centerville.
 - R02 Deed Book "D" at page 990 - Kirk's Addition to the Town of Centerville.
 - R03 Deed Book "F" at page 425 - Kirk's 2nd Addition to the Town of Centerville.
 - R04 Plat Book 1 at page 112 - Kirk's 3rd Addition to the Town of Centerville.
 - R05 Plat Book 1 at page 120 - Kirk's 4th Addition to the Town of Centerville.
 - R06 Plat Book 1 at page 93 - Railroad Addition to the Town of Centerville.
 - R07 Map N-70-B, Records of the Umatilla County Surveyor
 - R08 Map G-13-A, Records of the Umatilla County Surveyor
 - R09 Map M-82-A, Records of the Umatilla County Surveyor
 - R10 Map P-125-A, Records of the Umatilla County Surveyor
 - R11 Map S-105-B, Records of the Umatilla County Surveyor
 - R12 Map 83-76-C, Records of the Umatilla County Surveyor
 - R13 Map 87-21-A, Records of the Umatilla County Surveyor
 - R14 Map 88-81-B, Records of the Umatilla County Surveyor
 - R15 Map 90-11-A, Records of the Umatilla County Surveyor
 - R16 Map 93-041-B, Records of the Umatilla County Surveyor
 - R17 Map 93-044-B, Records of the Umatilla County Surveyor
 - R18 Map 93-045-B, Records of the Umatilla County Surveyor
 - R19 Map 95-057-B, Records of the Umatilla County Surveyor
 - R20 Map 95-058-B, Records of the Umatilla County Surveyor
 - R21 Report of Block 6 of Kirk's 2nd Addition to the City of Athena - Vol 13 of Plats, Pg 62, Records of Umatilla Co
 - R22 McKern's Replat, records of Umatilla County, Oregon

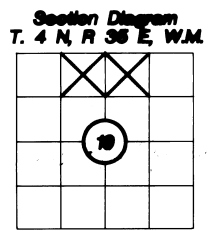

A Record of Survey for
Ed Verkiest
P.O. Box 568
Weston, Oregon 97886
Ph: (541) 566 - 3690

Dwight M. Bartleson L.S.
79902 LaMar Gulch Road
Athena, Oregon 97813
(541) 566 - 2397

Drawn By: DMB Date: Jan 31, 2000 Sheet 1 of 1

RECEIVED BY
Umatilla County Surveyor
Date: 3-20
Drawn By: KB
DA - 11112