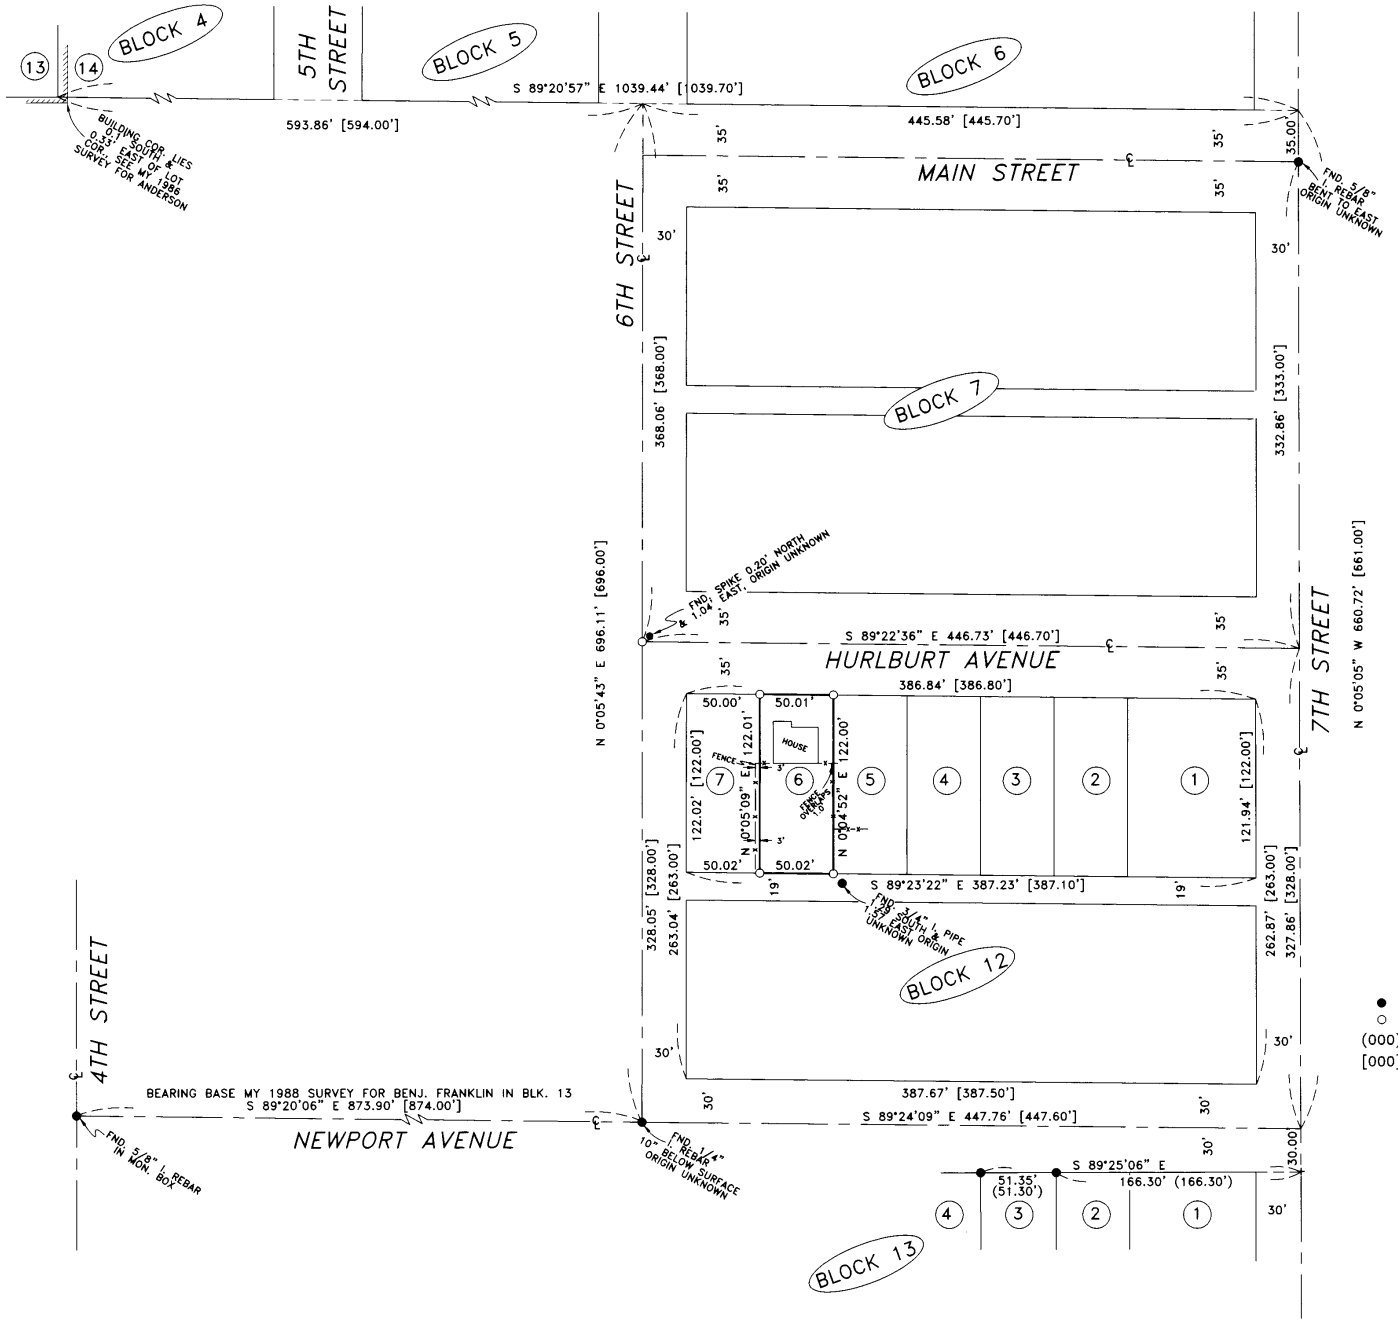

NARRATIVE:

THE PURPOSE OF THIS SURVEY IS TO STAKE THE CORNERS OF LOT 6 BLOCK 12 "NEWPORT ADDITION" TO THE CITY OF HERMISTON FOR A PENDING SALE AND TO SEE HOW FAR THE FENCES ARE OFF.

I HAVE DONE SURVEYS SOUTH AND AND NORTHWEST OF HERE AND THE MONUMENTS WHICH I USED MATCH THE ORIGINAL 1908 PLAT VERY WELL. I BASED THE BEARINGS ON MY 1988 SURVEY FOR BENJ. FRANKLIN SAVING AND LOAN IN BLOCK 13.

REGISTERED PROFESSIONAL LAND SURVEYOR

G. Dennis Edwards

OREGON
JULY 16, 1971
G. DENNIS EDWARDS
951
RENEWS 12/31/2001

N

SCALE: 1"=60'
0 60

LEGEND:

● MONUMENTS FOUND AS NOTED
○ SET 5/8"X30" IRON REBAR WITH PLASTIC CAP #951
(000) OF RECORD MY 1988 SURVEY FOR BENJAMIN FRANKLIN S & L
[000] OF RECORD PLAT OF "NEWPORT ADDITION"

SURVEY FOR CHARLES SAYLER, C/O ALL STAR REALTY
LOT 6, BLK. 12, "NEWPORT ADDITION", IN
NE 1/4, SW 1/4, SEC. 11, T 4 N, R 28 E, W.M.,
UMATILLA COUNTY, OREGON
5/19/2000 JOB# S0005092
EDWARDS SURVEYING P.O. BOX 763
541-567-3336 HERMISTON, OREGON 97838
DRAWN BY NJF

RECEIVED BY
Umatilla County Surveyor
Date 9-00
Rec'd By KK
No. 00-196-B