


## BASIS OF BEARING

The Easterly line of Parcel 1 of Minor Partition Plat Number 2000-43 being North 24°05'47" West, as per said Partition Plat

SCALE: 1" = 200'

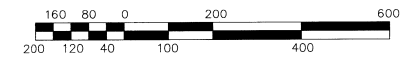

## REFERENCE MATERIAL

Survey Number 88-85-C  
Plat of Wal-Mart Subdivision  
Partition Plat Number 2000-43

## NARRATIVE

This survey was done at the request of Jim Towslee of Pacific Land Design. The purpose of this survey is to document the monumentation of an angle point on the exterior of Partition Plat Number 2000-43. I could not find the monument called for at the angle point near the Southeastery corner of the partition. The remaining corner monuments of the partition were found as shown. I also set reference pins along the North and South lines of the partition, as the Northwest and Southwest corners fall in the Umatilla River. The Northwest corner is exposed now, but remains underwater when the river is at a higher level.

REGISTERED  
PROFESSIONAL  
LAND SURVEYOR

*Rick G. Robinson*

OREGON  
JULY 17, 1986  
RICK G. ROBINSON  
2219

Renewal Date: Dec. 31, 2002

## LEGEND

- Found 5/8" iron pin with aluminum cap marked KEL PLS 933 set by Partition Plat Number 2000-43
- Found 5/8" iron pin with plastic cap marked WORLEY 13352 set by the plat of WAL-MART SUBDIVISION
- Set 5/8"x30" iron pin with plastic cap marked "BGB SURVEY MARKER" (set Dec. 20, 2000)
- Centerline
- x-x-x- Existing Fence Line
- ==== Railroad Track

Umatilla County Survey  
01-01  
KK  
01-06-B

BAGETT, GRIFFITH & BLACKMAN		
2006 Adams Avenue, LaGrande, Oregon		
Map of Survey		
Parcels 1 and 2 of Partition Plat Number 2000-43, filed September 18, 2000, Umatilla County Records, situated in the East 1/2 of Section 9, Township 2 North, Range 32 East of the Willamette Meridian, City of Pendleton, Umatilla County, Oregon.		
SURVEYED FOR	Pacific Land Design	
SURVEYED BY	R.G.R.	10/21-12/20/00
Scale: 1" = 200'	Drawn by: R.G.R.	1/15/01