RECORD OF SURVEY

LOT 3 , BLOCK D
HERMISTON ORCHARDS, TO THE CITY
OF HERMISTON OREGON
IN SEC 11, T4N, R28E, W.M.
UMATILLA COUNTY, OREGON

SURVEYOR'S NARRATIVE

THIS SURVEY WAS PERFORMED AT THE REQUEST OF JEFFREY S. CARRICK TO MONUMENT THE LOT CORNERS LOCATED ON R 357 PG 0436 LOCATED WITHIN BLOCK "D" HERMISTON ORCHARDS ALL WITHIN SECTION 11, TOWNSHIP 4 NORTH, RANGE 28 EAST OF THE WILLAMETTE MERIDIAN, UMATILLA COUNTY, OREGON.

A 5/8 INCH IRON ROD WAS FOUND AT A POINT MARKING THE ℄ INTERSECTION OF EAST MAIN STREET WITH THE ℄ INTERSECTION OF 7TH STREET. A 5/8 INCH IRON ROD WAS FOUND AT A POINT MARKING THE ℄ INTERSECTION OF EAST MAIN STREET WITH THE ℄ INTERSECTION OF 9TH STREET.

THE NORTHEAST AND NORTHWEST CORNERS SET BY EDWARDS FOR HUGHES ENTERPRISES WERE FOUND AND FIT RATHER WELL. I PROPORTIONED IN THE CORNERS TO BE SET USING THIS FOUND INFORMATION. THE BASIS OF BEARING FOR THIS SURVEY WAS THE FOUND 5/8 INCH IRON ROD AT THE INTERSECTION OF EAST MAIN AND 9TH STREET AND THE 5/8 INCH IRON ROD FOUND AT THE INTERSECTION OF EAST MAIN AND 7TH STREET.

LEGEND

- ○ SET 5/8" x 30" IRON ROD WITH YELLOW PLASTIC CAP STAMPED PLS LS 48509
- ● FND 5/8" IRON ROD EDWARDS
- □ FOUND 1/2" IRON ROD, NO CAP ORIGIN UNKNOWN

DEEDS

R 276 PG 907
R 357 PG 0436
BK 226 PG 304

SURVEYS

ORIGINAL HERMISTON ORCHARDS ADDITION PLAT GEARY KIMBRELL.

EDWARDS SURVEY FOR HUGHES ENTERPRISES.

NOTES

(M) MEASURED
(C) CALCULATED
(R) RECORD

SURVEYOR'S CERTIFICATION

I, BRIT L. PRIMM, A PROFESSIONAL LAND SURVEYOR IN THE STATE OF OREGON HEREBY CERTIFY THAT THIS MAP CORRECTLY REPRESENTS A SURVEY CONDUCTED UNDER MY DIRECT SUPERVISION IN SEPTEMBER 2001, IN CONFORMANCE WITH THE REQUIREMENTS OF THE SURVEY RECORDING LAW, AS ESTABLISHED BY ORS CHAPTER 92.

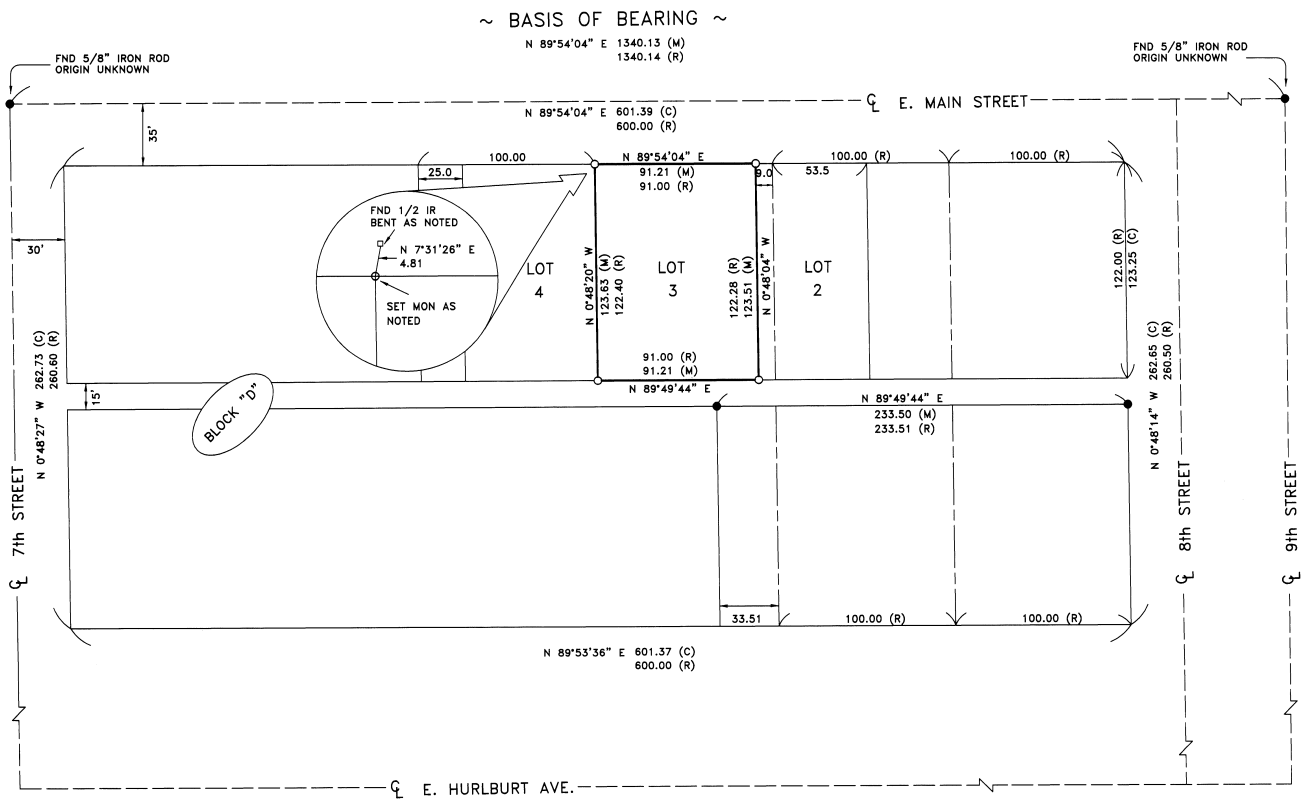

1" = 50'

REGISTERED
PROFESSIONAL
LAND SURVEYOR
OREGON
JULY 13, 1999
BRIT L. PRIMM
48509
EXPIRATION DATE: 12/31/02

DATE 10/1/01

PRIMM LAND SURVEYING
P.O. BOX 1322, 775 S.E. 10TH
HERMISTON, OR 97838
BUI (541) 564-7887
FAX (541) 567-8020
pls@oregontrail.net

RECEIVED BY
Umatilla County Surveyor
Date 9-01
By BK
01-148-B

CLIENT: JEFFREY S. CARRICK

SEC 11, T4N, R28E, W.M. UMATILLA COUNTY OREGON

PROJECT:

MONUMENT THE CORNERS OF LOT 3, BLOCK "D", HERMISTON ORCHARDS HERMISTON OREGON, SEC 11, T4N, R28E, W.M.

JOB#:	0109002
DATE:	9/8/01
FB/PG:	6/23
SHEET:	1 OF 1
DRAWN BY:	BLP
APPROVED:	BLP