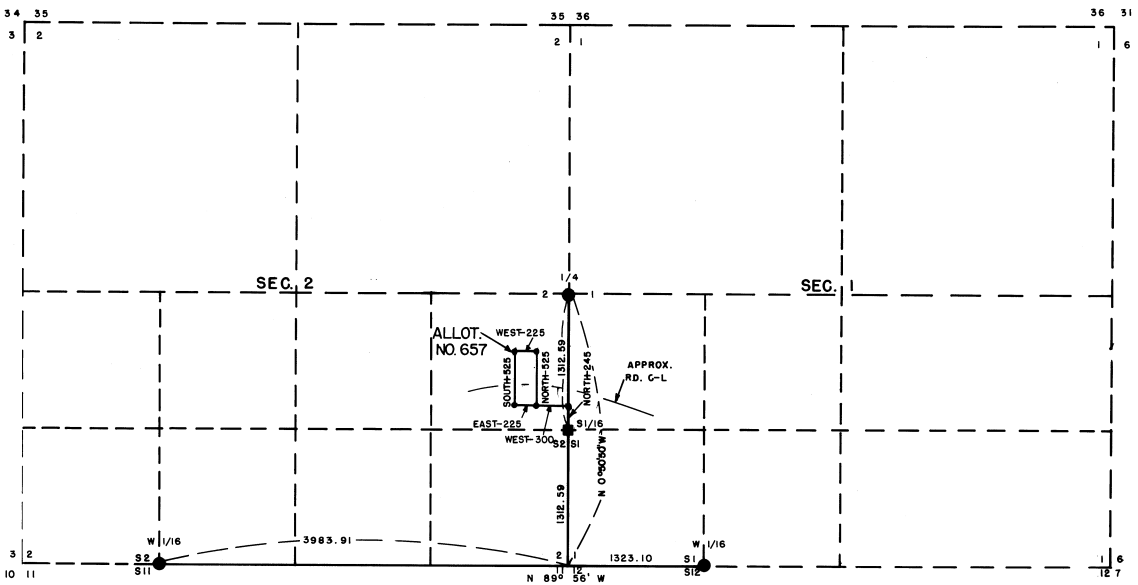

UMATILLA INDIAN RESERVATION BOUNDARY

● INDICATES 1 1/2" I. PIPE W/BR. CAP FND.

■ INDICATES 1 1/2" I. PIPE W/BR. CAP SET.

• INDICATES 5/8" I. PIN SET.

NOTE: BEARINGS ARE BASED UPON ORIGINAL BEARINGS FOR SOUTH LINE OF UMATILLA INDIAN RESERVATION.

REGISTERED
OREGON
LAND SURVEYOR
David H. Krumbein
JULY 17, 1970
DAVID H. KRUMBEIN
933

RECEIVED BY
Umatilla County Surveyor
Date 3-02
Rec'd By KE
No. 02-65-B

WAYNE HARRIS COMPANY, INC.			
SURVEY FOR			
BUREAU OF INDIAN AFFAIRS			
SEC. 2, T. 1 S., R. 33 E., W.M.			
SCALE	DATE	DRN. BY	DRNG. NO.
1" = 800'	6-2-71	DNS	71-274-C