




FARM UNIT "B"

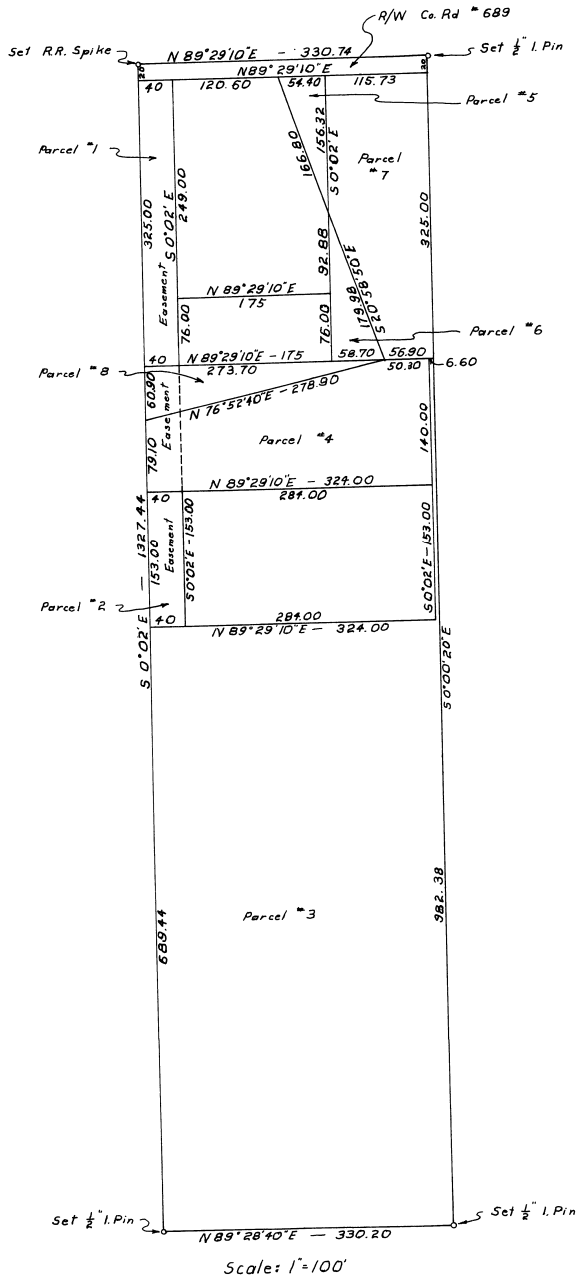

Vicinity Map
Sec. 6, T.4 N., R.29 E

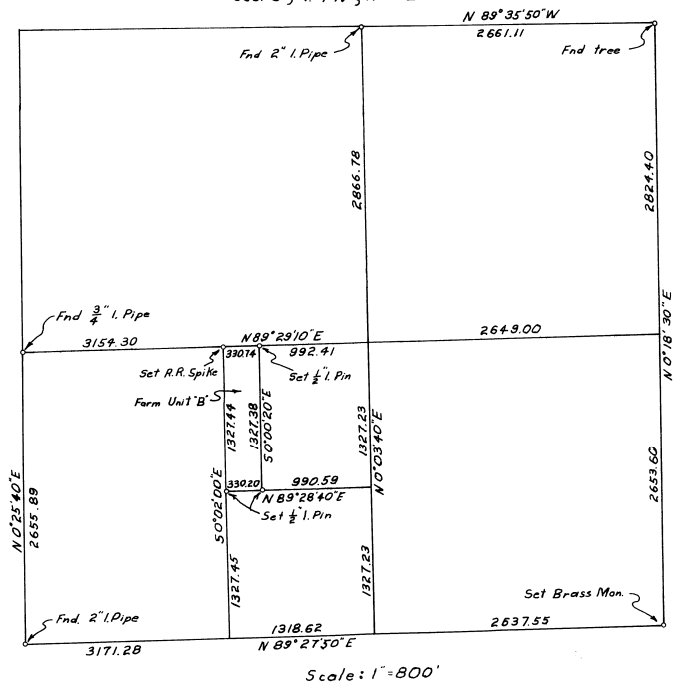

03-280-B

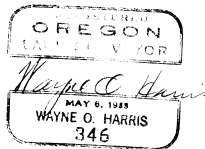

WAYNE O. HARRIS & ASSOC.			
SURVEY FOR TUM-A-LUM LUMBER COMPANY W 1/2 of the W 1/2 of the NE 1/4 of the SW 1/4, Sec. 6, T.4 N., R.29 E., W.M.			
SCALE	DATE	DRN. BY	DRNG. NO.
1" = 100'	10-29-68	DKH	68-222-C