


04-235-B

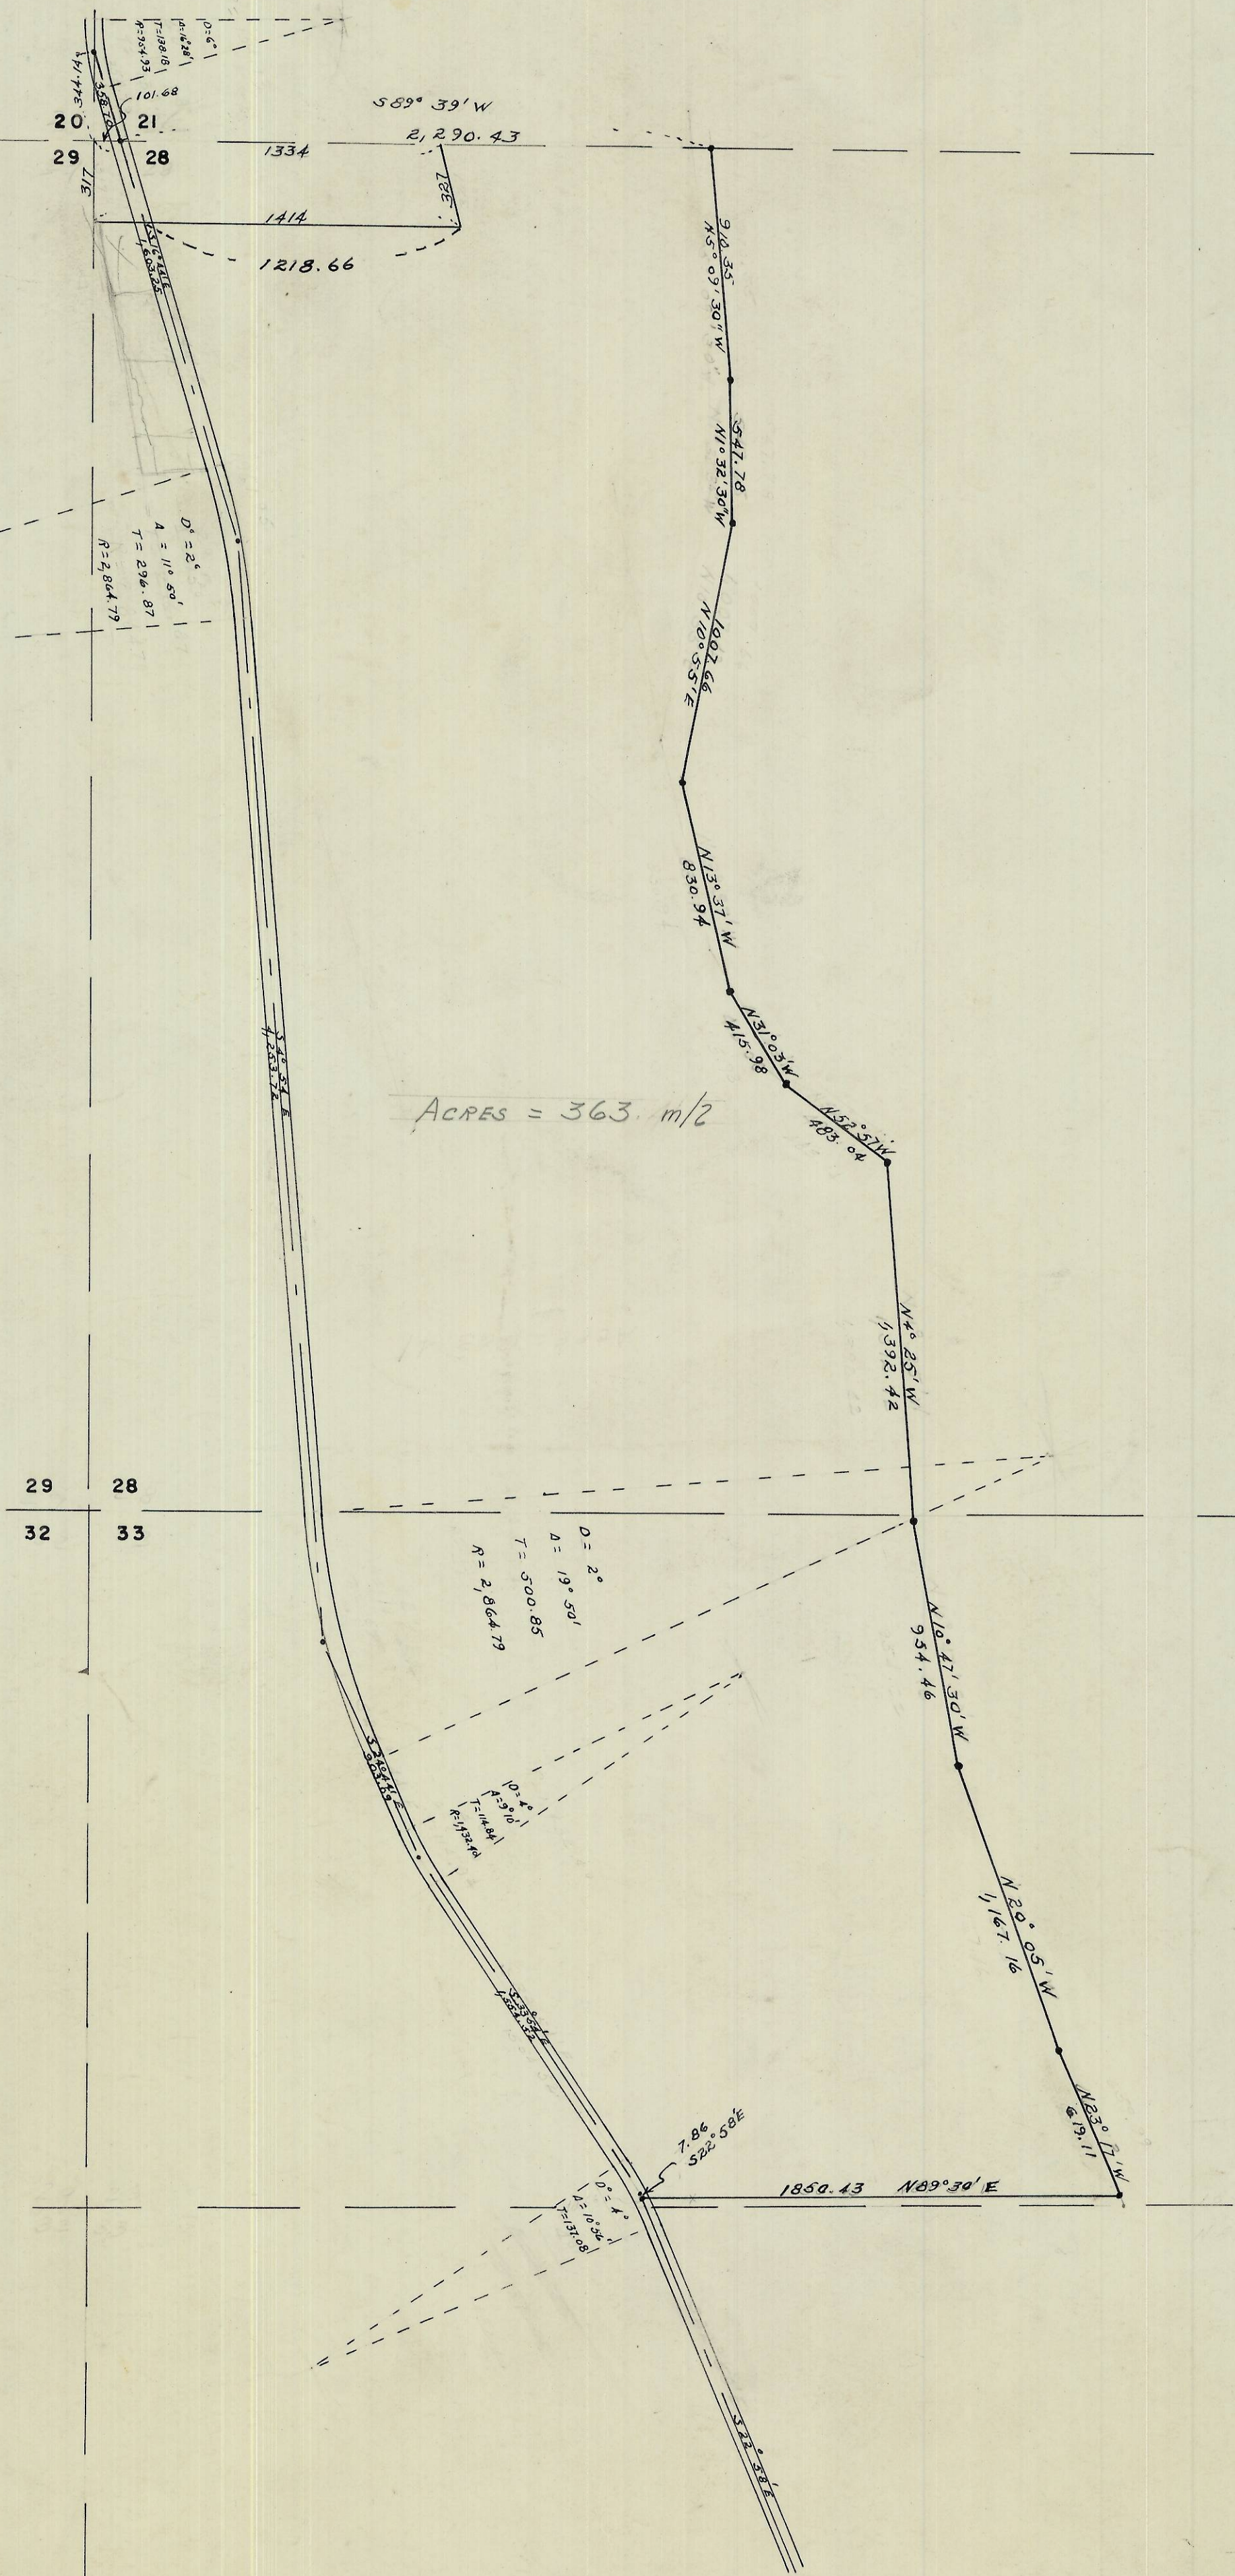


ACRES = 363. m/2



LEGEND

• 1/2" X 3/4" IRON PIN

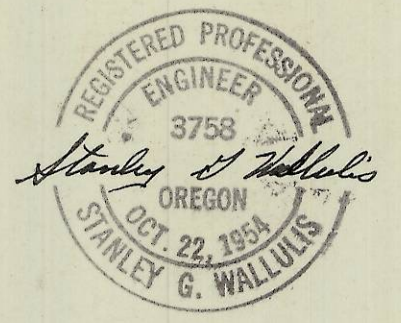

LEVI ELDRIDGE	
SECTIONS 28 & 33	
T I S R 32 E W M	
Scale 1"=500'	Des. Dr. Ck. CAE
Date 6-30-56	Dr No
VERNON B. TENNESON & ASSOC.	
PENDLETON	OREGON

04-235-B