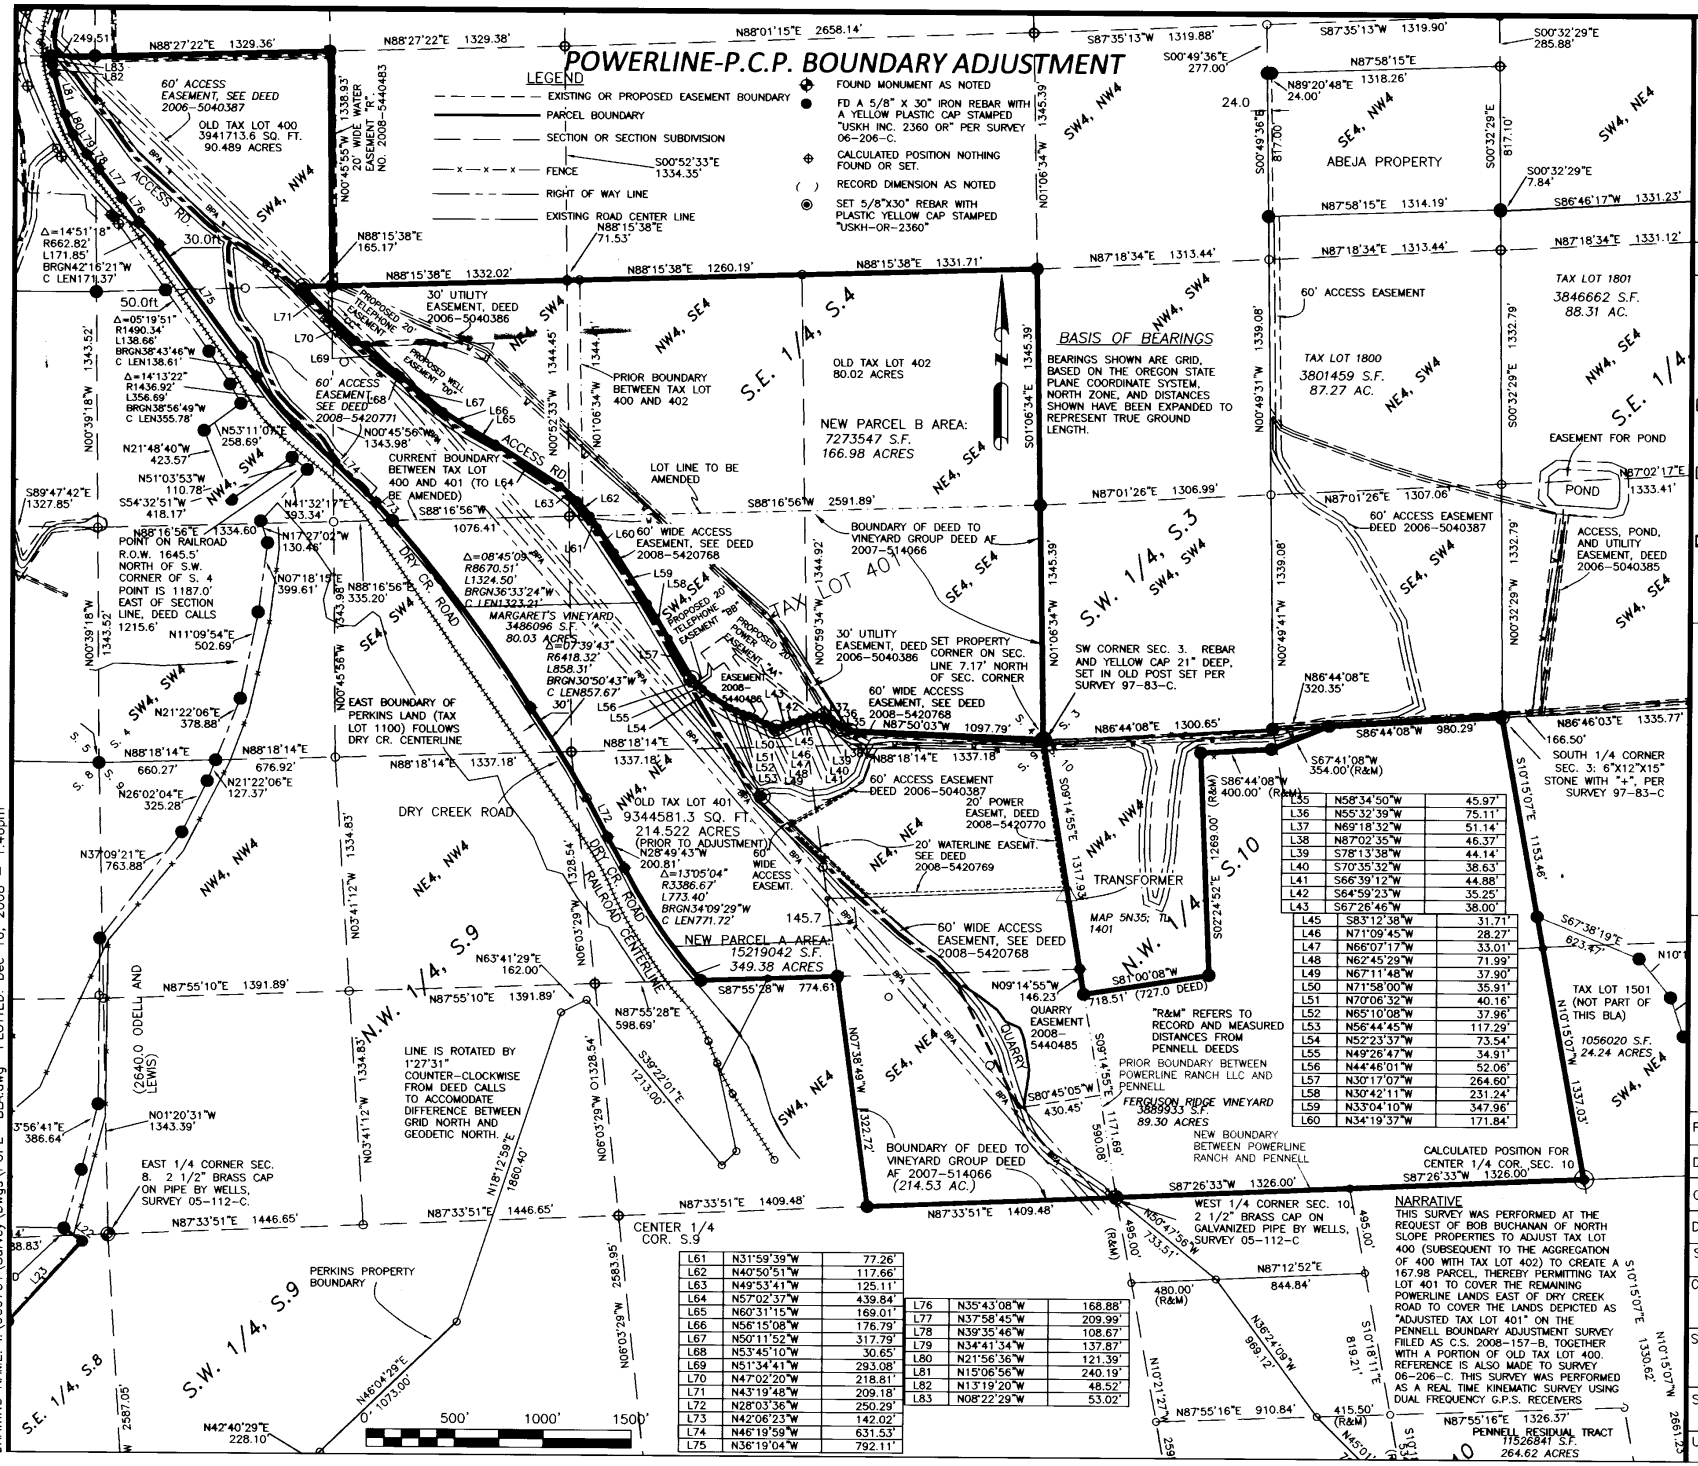


L35	N58°34'50"W	45.97'
L36	N55°32'39"W	75.11'
L37	N69°18'32"W	51.14'
L38	N87°02'35"W	46.37'
L39	S78°13'38"W	44.14'
L40	S70°35'32"W	38.63'
L41	S66°39'12"W	44.88'
L42	S64°59'23"W	35.25'
L43	S67°26'46"W	38.00'
L45	S83°12'38"W	31.71'
L46	N71°09'45"W	28.27'
L47	N66°07'17"W	33.01'
L48	N62°45'29"W	71.99'
L49	N67°11'48"W	37.90'
L50	N71°58'00"W	35.91'
L51	N70°06'32"W	40.16'
L52	N65°10'08"W	37.96'
L53	N56°44'45"W	117.29'
L54	N52°23'37"W	73.54'
L55	N49°26'47"W	34.91'
L56	N44°46'01"W	52.06'
L57	N30°17'07"W	264.60'
L58	N30°42'11"W	231.24'
L59	N33°04'10"W	347.96'
L60	N34°19'37"W	171.84'

L61	N31°59'39"W	77.26'
L62	N40°50'51"W	117.66'
L63	N49°53'41"W	125.11'
L64	N57°02'37"W	439.84'
L65	N60°31'15"W	169.01'
L66	N56°15'08"W	176.79'
L67	N50°11'52"W	317.79'
L68	N53°45'10"W	30.65'
L69	N51°34'41"W	293.08'
L70	N47°02'20"W	218.81'
L71	N43°19'48"W	209.18'
L72	N28°03'36"W	250.29'
L73	N42°06'23"W	142.02'
L74	N46°19'59"W	631.53'
L75	N36°19'04"W	792.11'

L76	N35°43'08"W	168.88'
L77	N37°58'45"W	209.99'
L78	N39°35'46"W	108.67'
L79	N34°41'34"W	137.87'
L80	N21°56'36"W	121.39'
L81	N15°06'56"W	240.19'
L82	N13°19'20"W	48.52'
L83	N08°22'29"W	53.02'

REGISTERED PROFESSIONAL LAND SURVEYOR
OREGON
JULY 26, 1988
PAUL W.P. TOMKINS
2360
RENEWS 6/30/2010

Date Stamped: 12/16/08

USKH
Engineering • Land Surveying
Planning • Materials Testing
☐ 313 D St. Suite 200 Lewiston, ID 83501 Phone: (208) 746-2661 Fax: (208) 746-6825
☐ 621 W. MALLON AVE. Suite. 309 Spokane, WA 99201 Phone: (509) 328-5139 Fax: (509) 328-0423
☒ 5 North Colville St. Walla Walla, WA 99362 Phone: (509) 522-4843 Fax: (509) 522-1902

Project:
A BOUNDARY ADJUSTMENT IN THE SW¼, NW¼, THE NW¼, SW¼, THE NE¼, SW¼, THE SE¼, SW¼, AND THE ENTIRE SE¼ OF SEC. 4, THE NE¼, NW¼, THE NW¼, NE¼, THE NE¼, NE¼, AND THE SE¼, NE¼ OF SEC. 9, AND THE ENTIRE NW¼ OF SEC. 10, ALL IN T5N, R35E, W.M., UMATILLA COUNTY, OR.

Client
NORTH SLOPE PROPERTIES
83501 LOWER DRY CR. RD.
MILTON FREEWATER, OR

Project Mgr.	PWPT
Drawn	PWPT
Checked	TSB
Date	DEC. 4, 2008
Scale	1"= 500'
CAD File:	\909701\POPE BLA.DWG
Sheet Contents:	
Sheet No.:	1 OF 1
U.S.K.H. W.O.	909701

NARRATIVE
THIS SURVEY WAS PERFORMED AT THE REQUEST OF BOB BUCHANAN OF NORTH SLOPE PROPERTIES TO ADJUST TAX LOT 400 (SUBSEQUENT TO THE AGGREGATION OF 400 WITH TAX LOT 402) TO CREATE A 167.98 PARCEL, THEREBY PERMITTING TAX LOT 401 TO COVER THE REMAINING POWERLINE LANDS EAST OF DRY CREEK ROAD TO COVER THE LANDS DEPICTED AS "ADJUSTED TAX LOT 401" ON THE PENNELL BOUNDARY ADJUSTMENT SURVEY FILED AS C.S. 2008-157-B, TOGETHER WITH A PORTION OF OLD TAX LOT 400. REFERENCE IS ALSO MADE TO SURVEY 06-206-C. THIS SURVEY WAS PERFORMED AS A REAL TIME KINEMATIC SURVEY USING DUAL FREQUENCY G.P.S. RECEIVERS

RECEIVED BY
Umatilla County Surveyor
Date: 12/17/08
Filed by: D. Tubbs
File No. 08-162-B

DRAWING NAME: 909701\Survey\Dwgs\POPE BLA.dwg PLOTTED: Dec 16, 2008 - 1:46pm

08-162-B