


Section 30
Tp 4 N, R 36 E. W.M.

Scale 1 inch = 400 feet

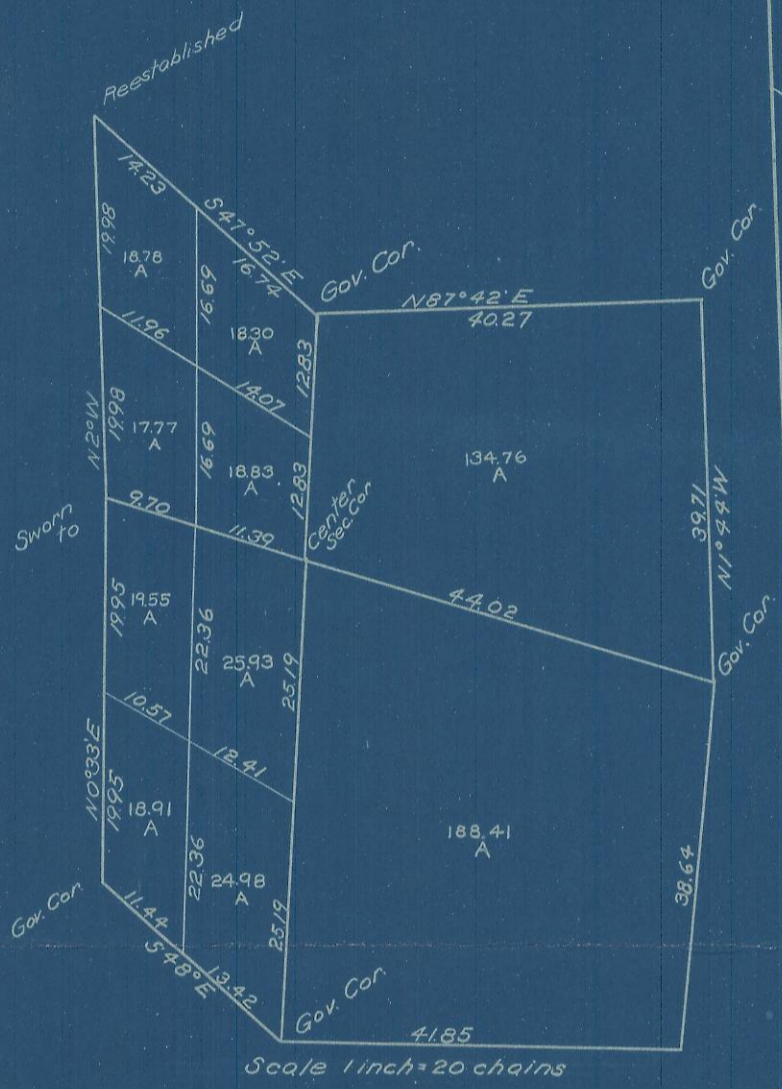

Scale 1 inch = 20 chains

SECTION 30 Tp 4 N, R 36 E. W.M.
as shown by survey and plat of
survey made by J.C. Arnold. The
field notes of said survey and
plat being recorded in book 1 of
of the record of Private Surveys
at page 230 et seq.

17.01	589° 33' E		
1.	34.03		
2.	34.03		
3.	34.04		
4.	34.04		
17.05	589° 35' E		

Scale 1 inch = 20 chains

SECTION 30 Tp 4 N, R 36 E. W.M.
as shown by United States Government
Township Plat.

11-147-B