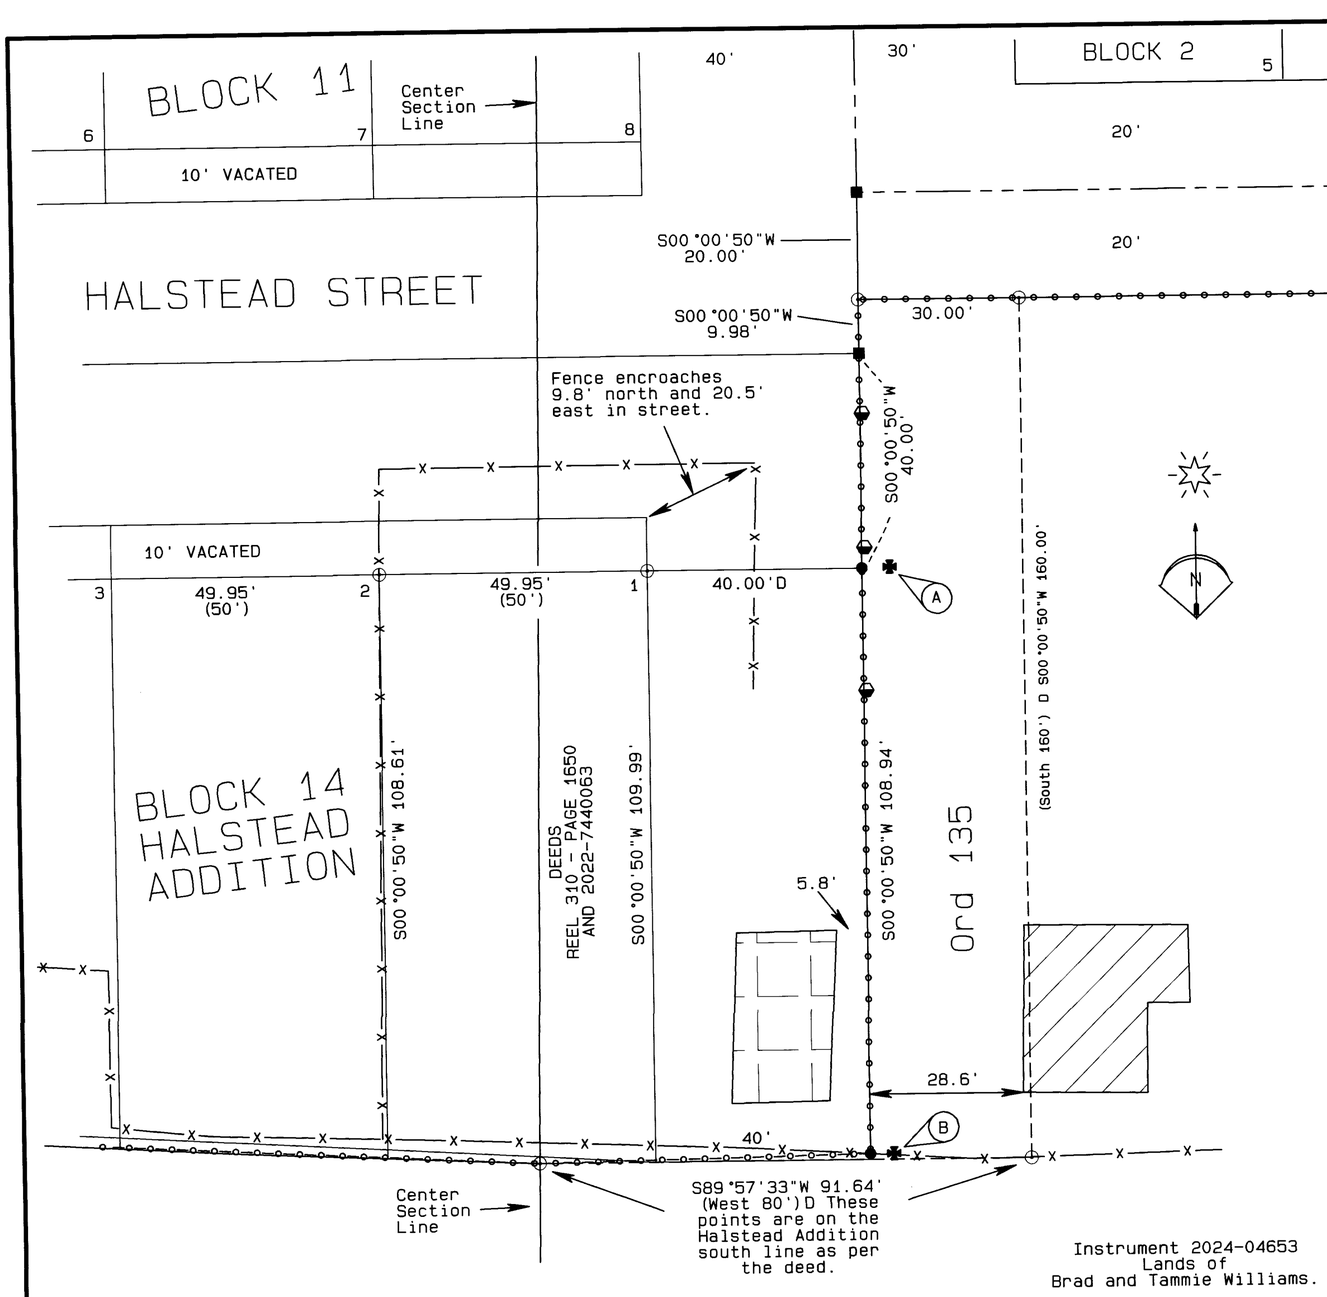

NARRATIVE OF SURVEY

This survey was performed at the request of Mrs. Tammie Williams. The purpose of the survey was to remonument the two points from Umatilla County Survey 25-32-C which are shown on this map as having been moved by others. When or by whom the monuments were moved is unknown. However, the original position where the monuments were set contained bits of the flagging that was attached to the rebar when the cap was set. In addition, the monument set on the south property line had the cap beaten down around the rebar to the point that the text on the cap was obliterated and the rebar exposed through the center of the cap.

New monuments were set in the original position as shown on this map and also on map of survey 25-32-C recorded in the County Surveyor's Office. The location of the moved monuments to the correct position is shown in the monument table. In addition to remonumenting the corner points, three steel fence "T" posts were set near the line and on the east side to help the location of the line be visible.

This survey was performed with a Trimble R8S, RTK Base / Rover pair.

REGISTERED PROFESSIONAL LAND SURVEYOR

Stephen K. Haddock

OREGON
JULY 9, 2001
STEPHEN K. HADDOCK
56295LS

RENEWS 6-30-27

LEGEND

- ● SET A 5/8" x 24" IRON REBAR W/ A 1 1/8" ORANGE PLASTIC CAP STAMPED WTS AND 56295LS.
- FOUND A 5/8" x 24" IRON REBAR W/ A 1 1/8" ORANGE PLASTIC CAP STAMPED WTS AND 56295LS. MOVED BY OTHERS.
- FOUND 1" SQUARE BRASS BOLT AS SHOWN ON SURVEY 02-103-B
- SET STEEL "T" POST NEAR THE PROPERTY LINE.
- COMPUTED POINT
- D RECORD DATA PER THE DEED
- DOG KENNEL
- SMALL SHED WITH ATTACHED GARAGE
- EXTERIOR LINE OF WILLIAMS TRACT 2024-04653

MONUMENT TABLE

(A) Moved monument bears N88°03'49"E 5.18 feet from true corner point. Cap is disturbed but legible.

(B) Moved monument bears N89°46'06"E 4.42 feet from true corner point. Cap is smashed down around pin and is not legible.

NOTE: For additional information concerning the establishment of the boundaries shown hereon see Umatilla County Survey 25-32-C

RECEIVED BY
Umatilla County Surveyor
Date: 5/20/25
Rec'd By: CT
No.: 25-046-B

SURVEY FOR
Mrs. Tammie Williams
P.O. Box 273
Echo, OR 97826

LOCATION: NW-SE & NE-SW of S16, T3N, R29E, W.M., Umatilla County, Oregon.

PROJECT DATE: April 25th, 2025

Project No. 24-13 | SCALE: 1" = 100'

WITNESS TREE SURVEYING
Stephen K. Haddock, PLS, CFedS
P.O. Box G
Pilot Rock, Oregon 97868
(541) 443-2922