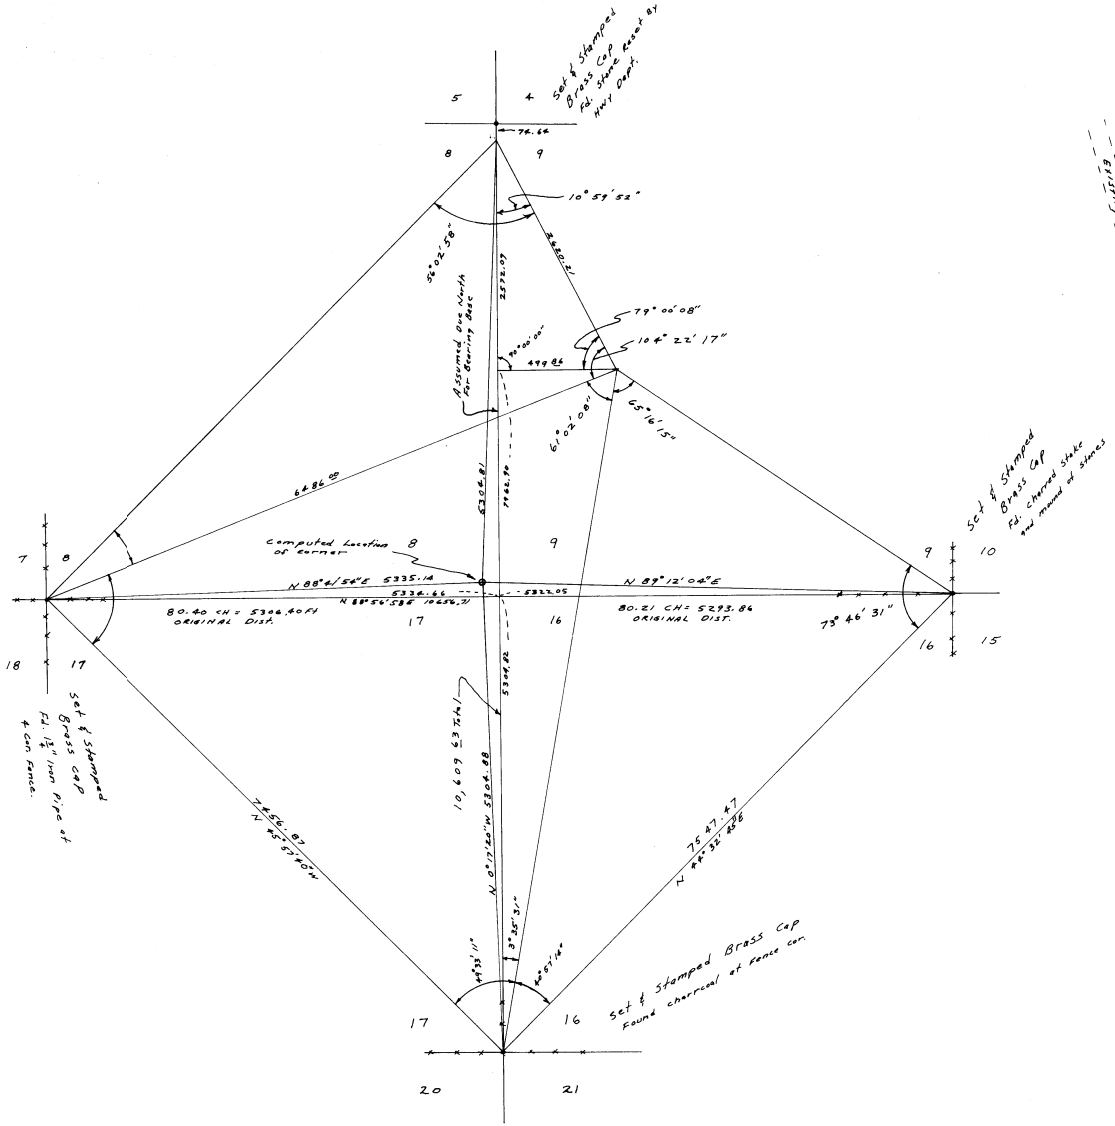

SCALE : 1" = 1000'

TRIANGLE CONTROL SURVEY TO LOCATE EAST LINE OF SECTION 17

T 3 N , R 29 E.W.M.

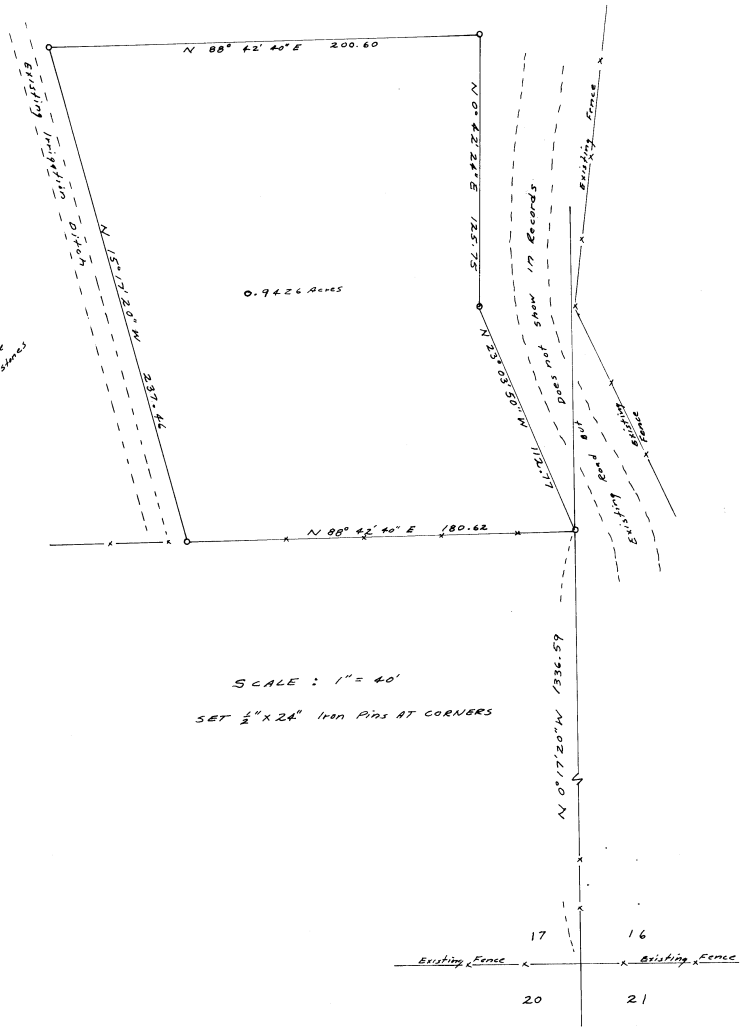

SCALE : 1" = 40'

SET ½" x 24" Iron Pins AT CORNERS

REGISTERED PROFESSIONAL ENGINEER 5408 OREGON JULY 9 1969 DONALD L. STAEBLER

NEW HOME SITE SURVEY FOR TONY CUNHA OF ECHO, OREGON

T 3 N, R 29 E.W.M.

DATE: 3-8-71 | SCALE: AS SHOWN

DONALD L. STAEBLER
CONSULTING ENGINEER
P.O. BOX 91
PENDLETON OREGON

H-4-B