
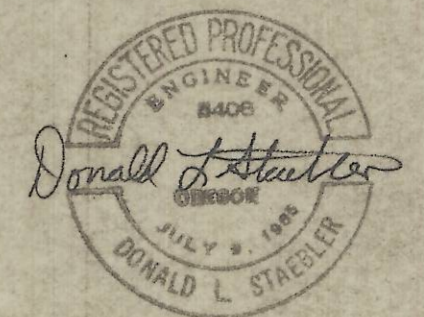


SCALE: 1" = 100'

DATE: 3-8-73

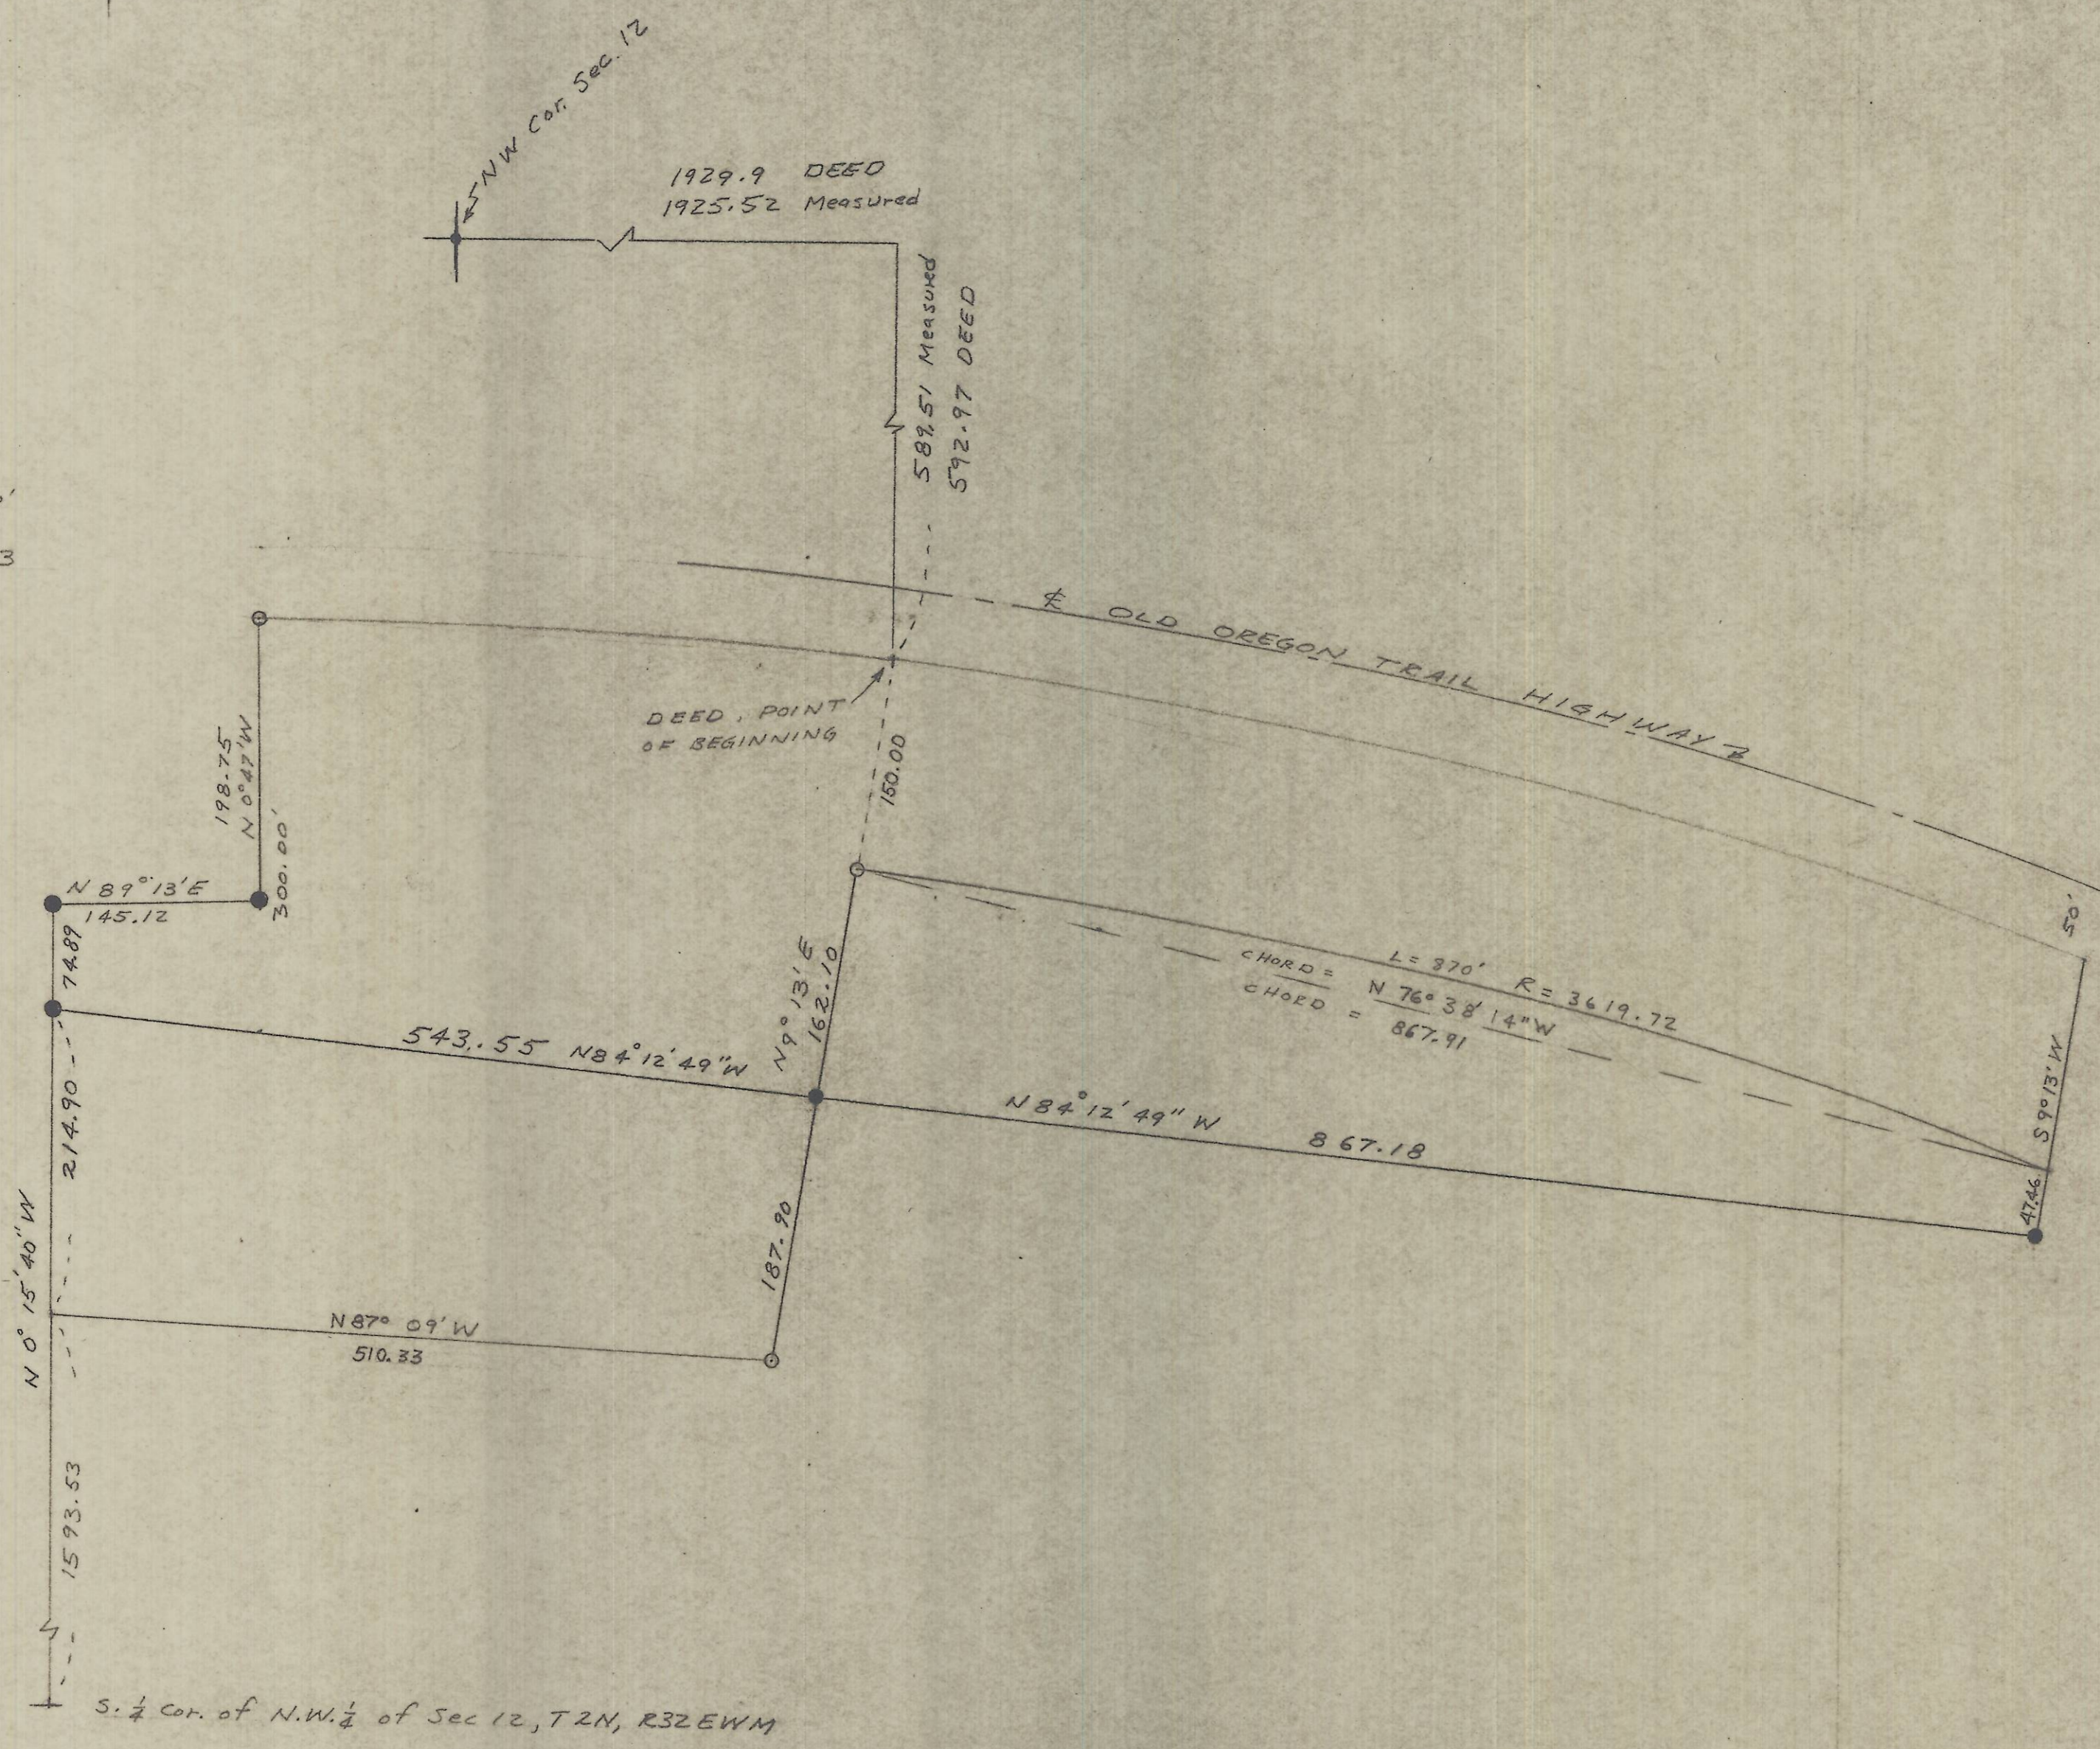

I-47<sup>B</sup>  
 Bearings Based on Deed. P280  
 LAND SURVEY FOR  
 ARROW CHEVROLET  
 IN N.W. 1/4 SEC. 12, T2N, R32E.  
 SCALE 1"=100' DATE: 4-21-73  
 DONALD L. STAEBLER  
 CONSULTING ENGINEER  
 PO BOX 91  
 PENDLETON OREGON