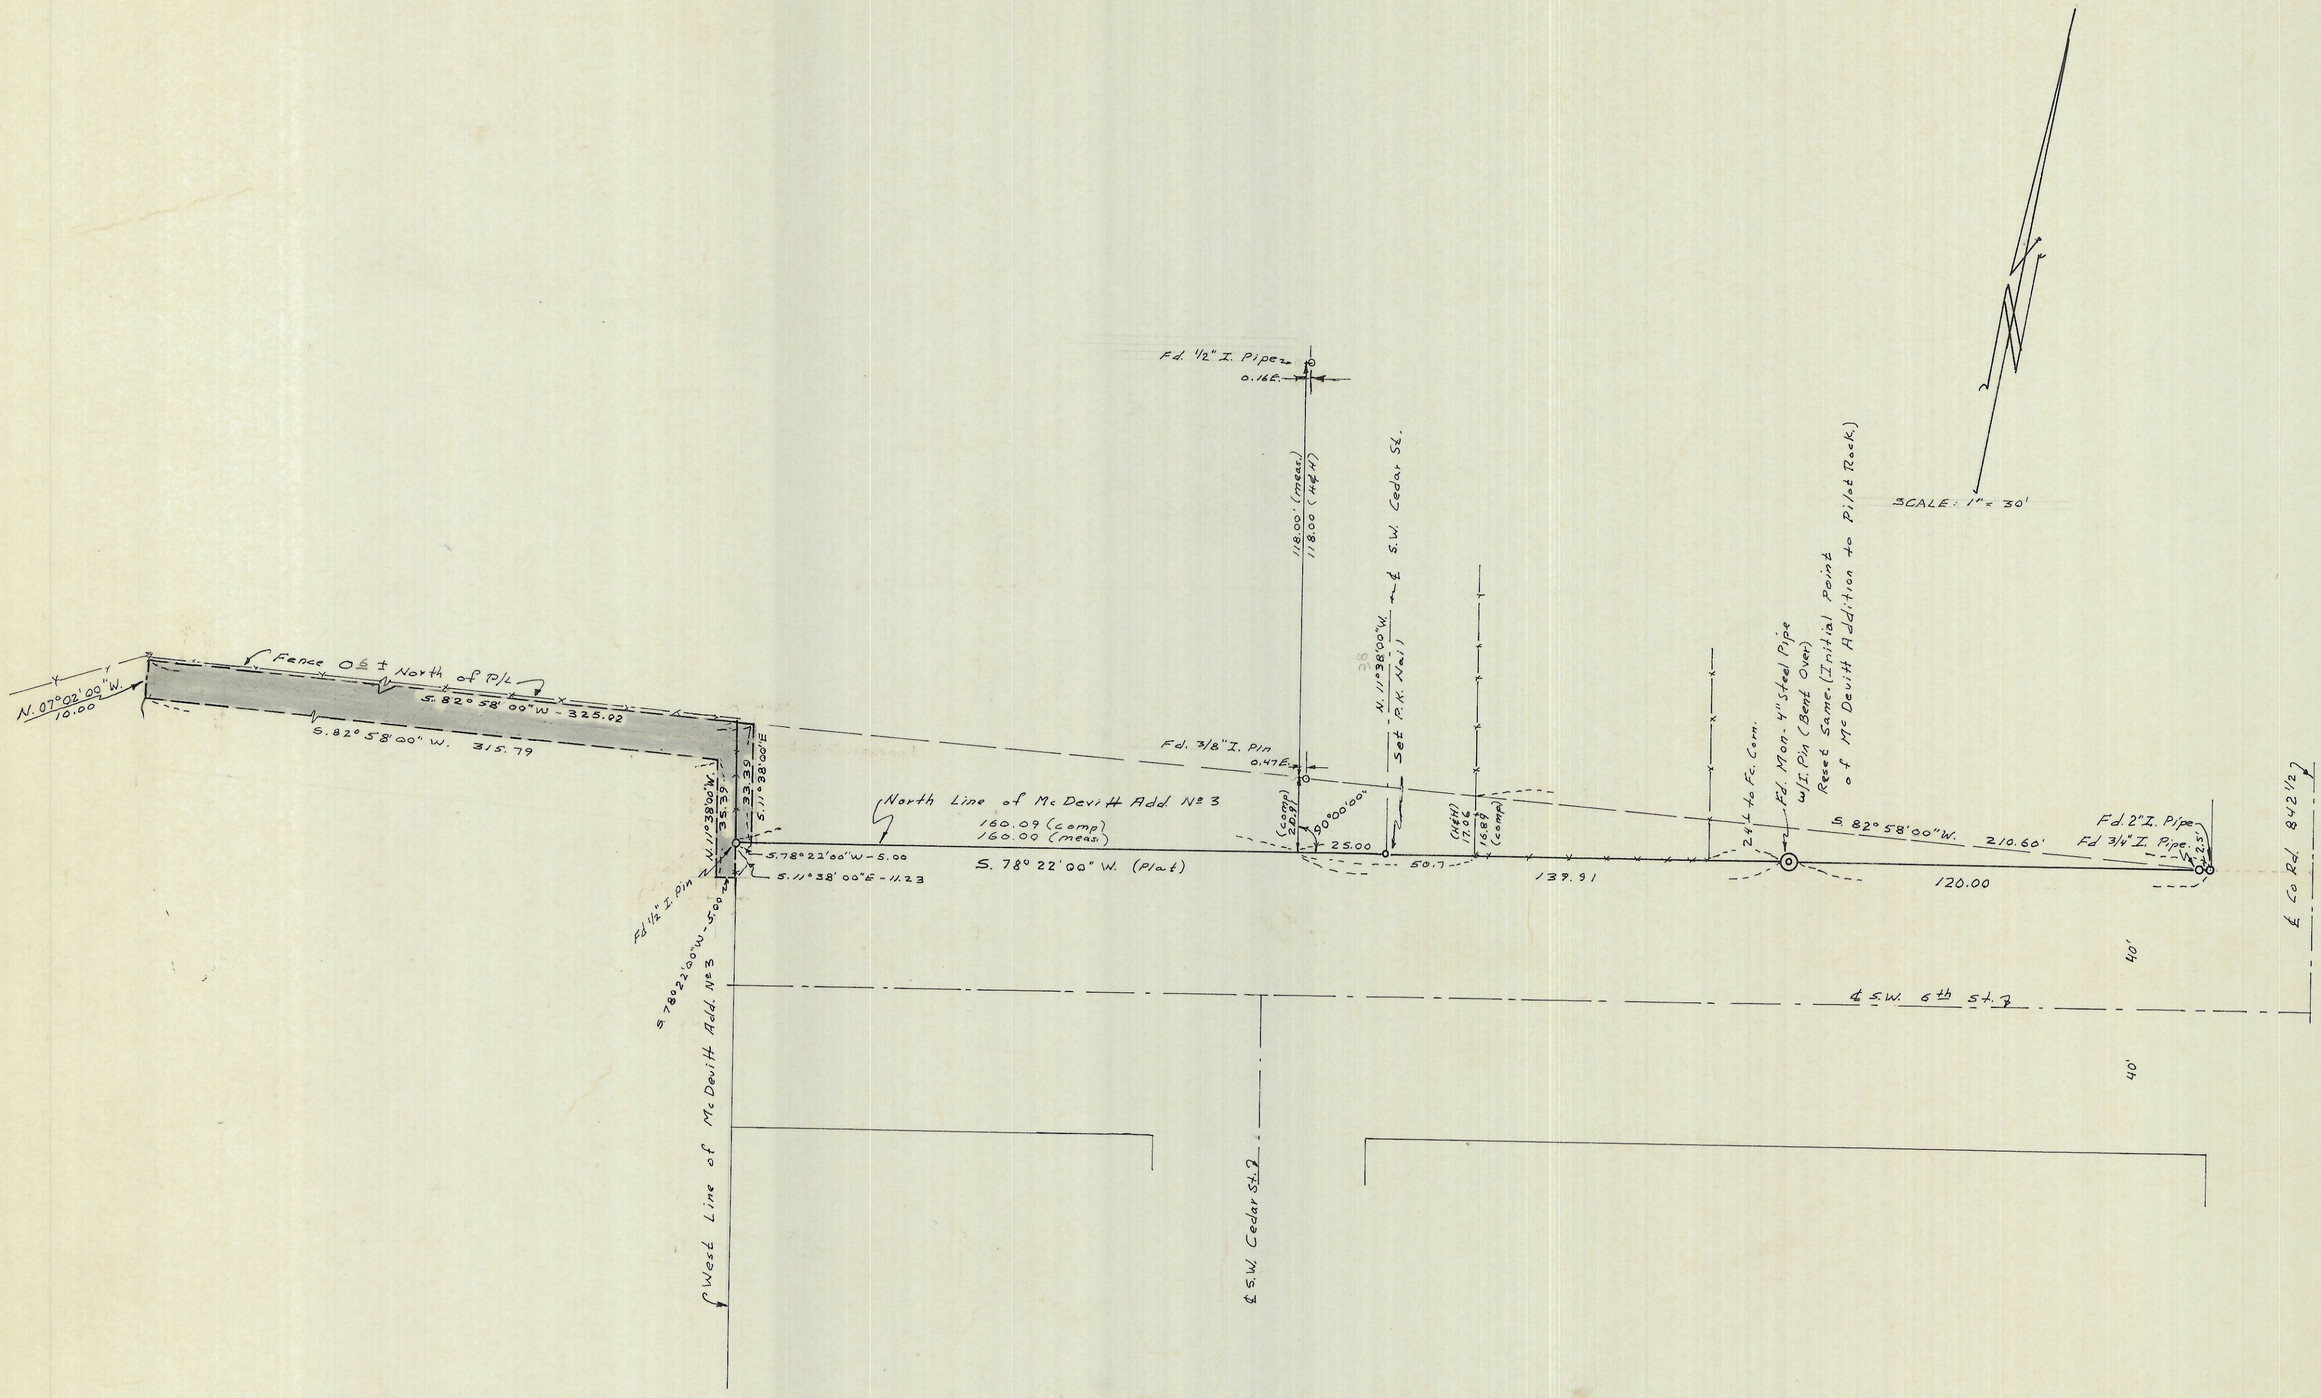

EASEMENT SURVEY
IN PILOT ROCK, OREGON

FOR CASCADE NATURAL GAS CO.
222 FAIRWAY AVENUE N.
SEATTLE, WASH. 98109

DWN: HFS	DATE: 4-11-74	SCALE: 1" = 30'

DONALD L. STAEBLER
CONSULTING ENGINEER
P. O. BOX 91
PENDLETON OREGON 97801

I-155-B

REGISTERED PROFESSIONAL ENGINEER 5408 OREGON JULY 9, 1965 DONALD L. STAEBLER
Donald L. Staebler