


SCALE: 1" = 400'

LEGEND

- FOUND BRASS CAP
- SET BRASS CAP
- SET 3/4" x 24" I. PIPE

NOTES

1. BEARINGS ARE BASED ON THE NORTH HALF OF THE WEST LINE BEING N. 00° 13' 00" W.
2. BRASS CAPS SET WERE STAMPED IN ACCORDANCE WITH THE MANUAL OF SURVEYING INSTRUCTIONS.

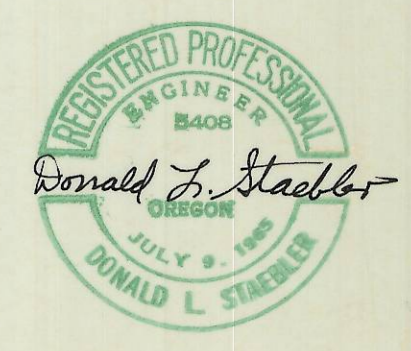

PROPERTY SURVEY FOR <b>KEITH ADAMS</b> IN THE NORTH HALF OF SECTION 32, T. 4N. R. 38 E.W.M.		
DATE: 12-13-74	DWN BY: HFS	SCALE: 1" = 400'
DONALD L. STAEBLER CONSULTING ENGINEER P.O. BOX 91 <b>I-156B</b> PENDLETON OREGON 97801		

T. 4 N. R. 38 E. 31 32  
T. 3 N. R. 38 E. 32 33  
S. 89° 54' 51" E. 5328.76'