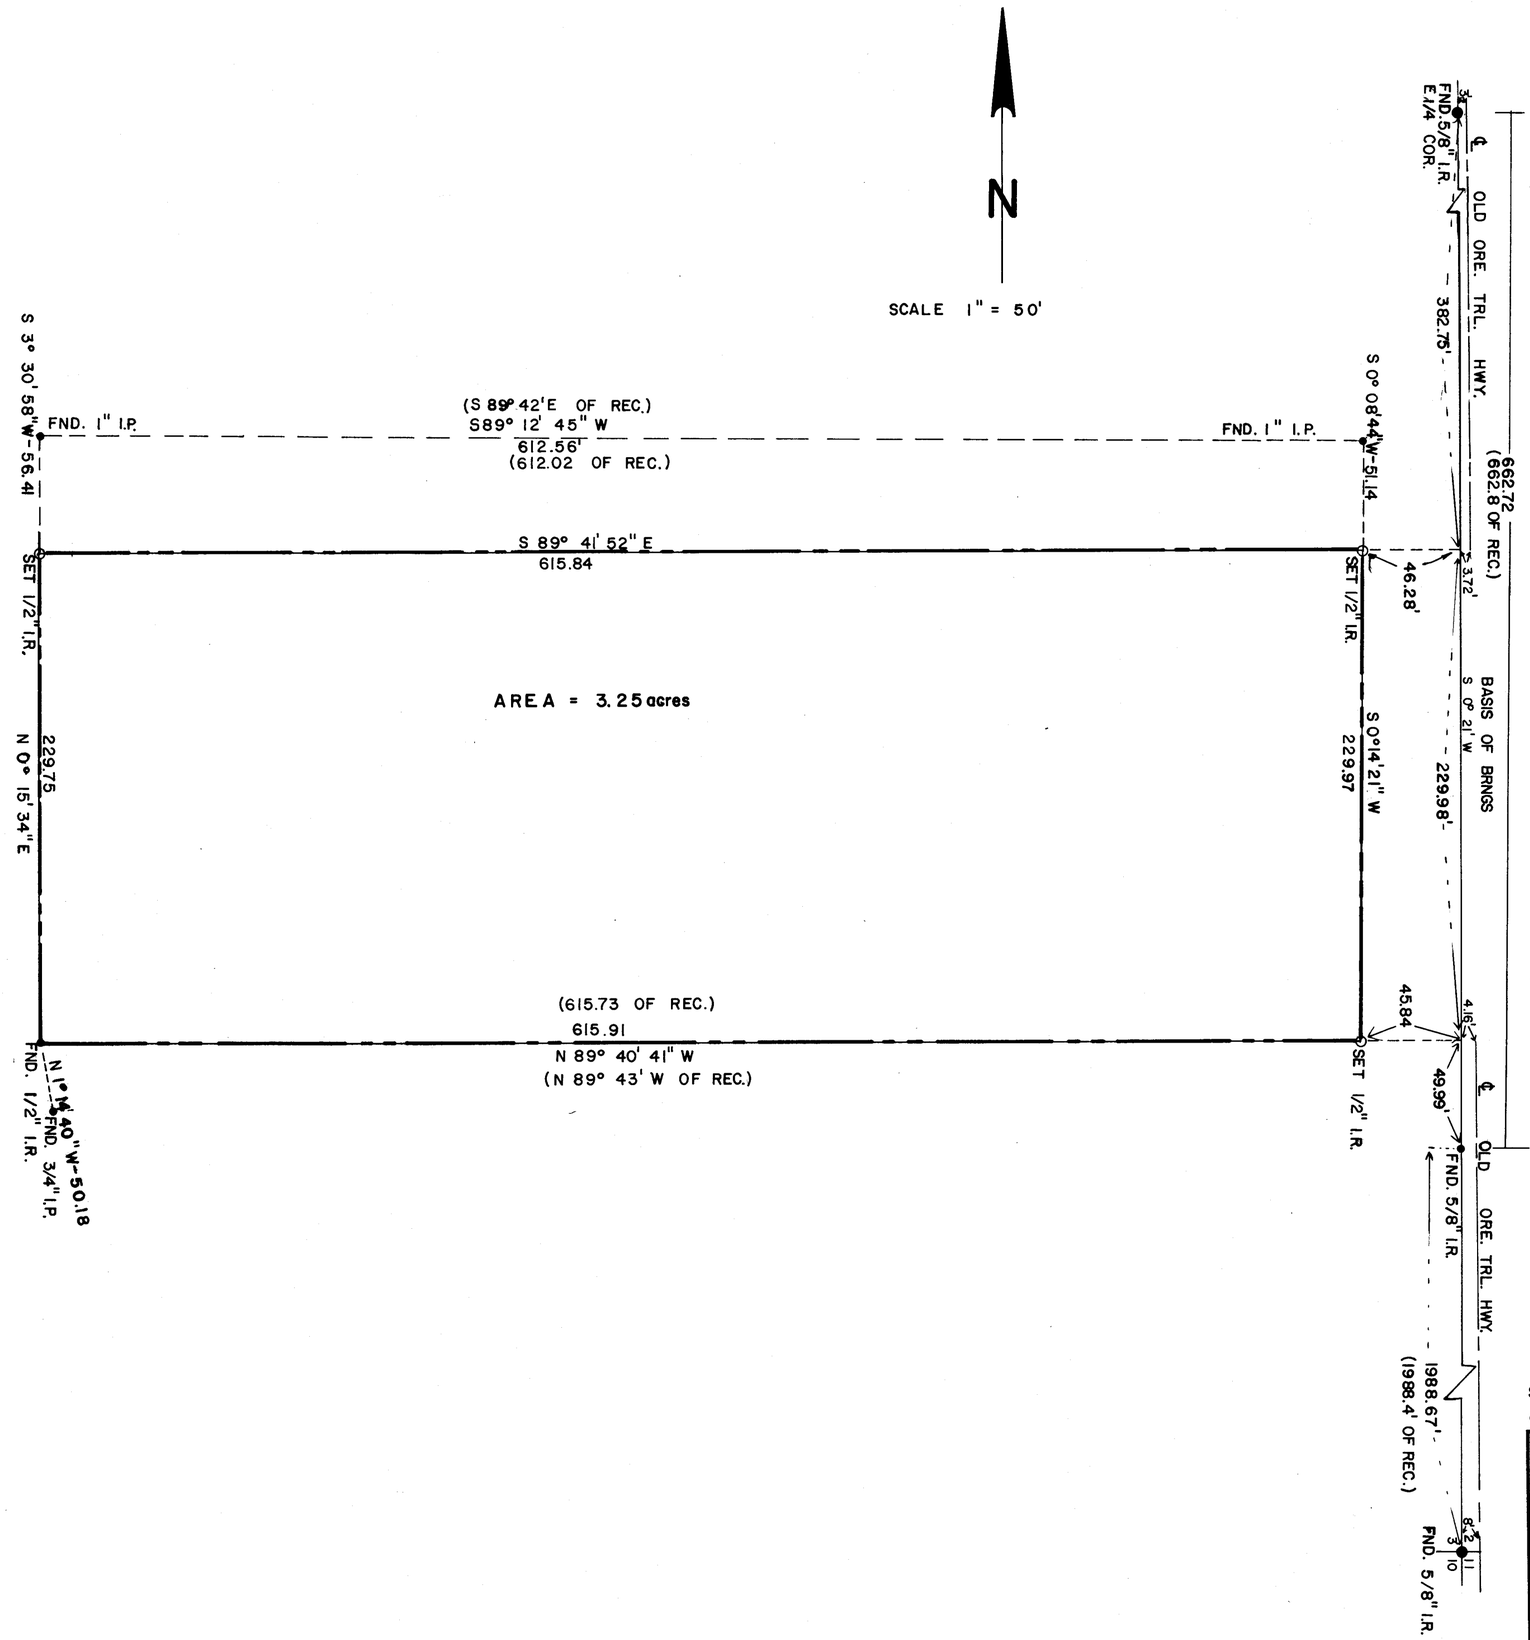

CERTIFICATION

I, G. DENNIS EDWARDS A REGISTERED PROFESSIONAL LAND SURVEYOR HEREBY CERTIFY THAT ON 9/17/75 A SURVEY WAS STARTED AND COMPLETED ON 9/19/75 OF THE LANDS SHOWN HEREON BY ME OR UNDER MY DIRECTION THAT THE PROPERTY CORNERS ARE MARKED AS SHOWN, AND THAT THIS MAP IS A TRUE AND ACCURATE REPRESENTATION OF SAID SURVEY.

REGISTERED PROFESSIONAL LAND SURVEYOR

G. Dennis Edwards

OREGON
JULY 15, 1971
G. DENNIS EDWARDS
951

LEGEND

- PROPERTY LINE
- DIMENSION & R/W LINE
- ℄
- ● POINTS FOUND AS NOTED
- ○ POINTS SET AS NOTED

J-045-B

IN THE S 1/2 OF NE 1/4, NE 1/4, SE 1/4, SECTION 3, T 4 N, R 28 E, W.M., UMATILLA COUNTY, OREGON

SURVEY FOR **ED McCALLUM**

GASCHLER & ASSOCIATES
ONTARIO, OREGON HERMISTON, OREGON

DESIGNED BY:	DRAWN BY:	APPROVED BY: G.D.E.
DATE: 9/22/75	DRAWING-NO. B-10	BK____ PG____
SHEET 1 OF 1	JOB NO. HSO-1075	REVISED:

IDAHO BLUEPRINT & SUPPLY CO., INC., BOISE, IDAHO