


SURVEY FOR
E.A. "TONY" ROSSMEIER
 SECTION 31 T. 4N., R37E.W.M.
 Scale 1" = 100' Nov. 9, 1974

Guy W. Streama, Jr.
 PROFESSIONAL ENGINEER

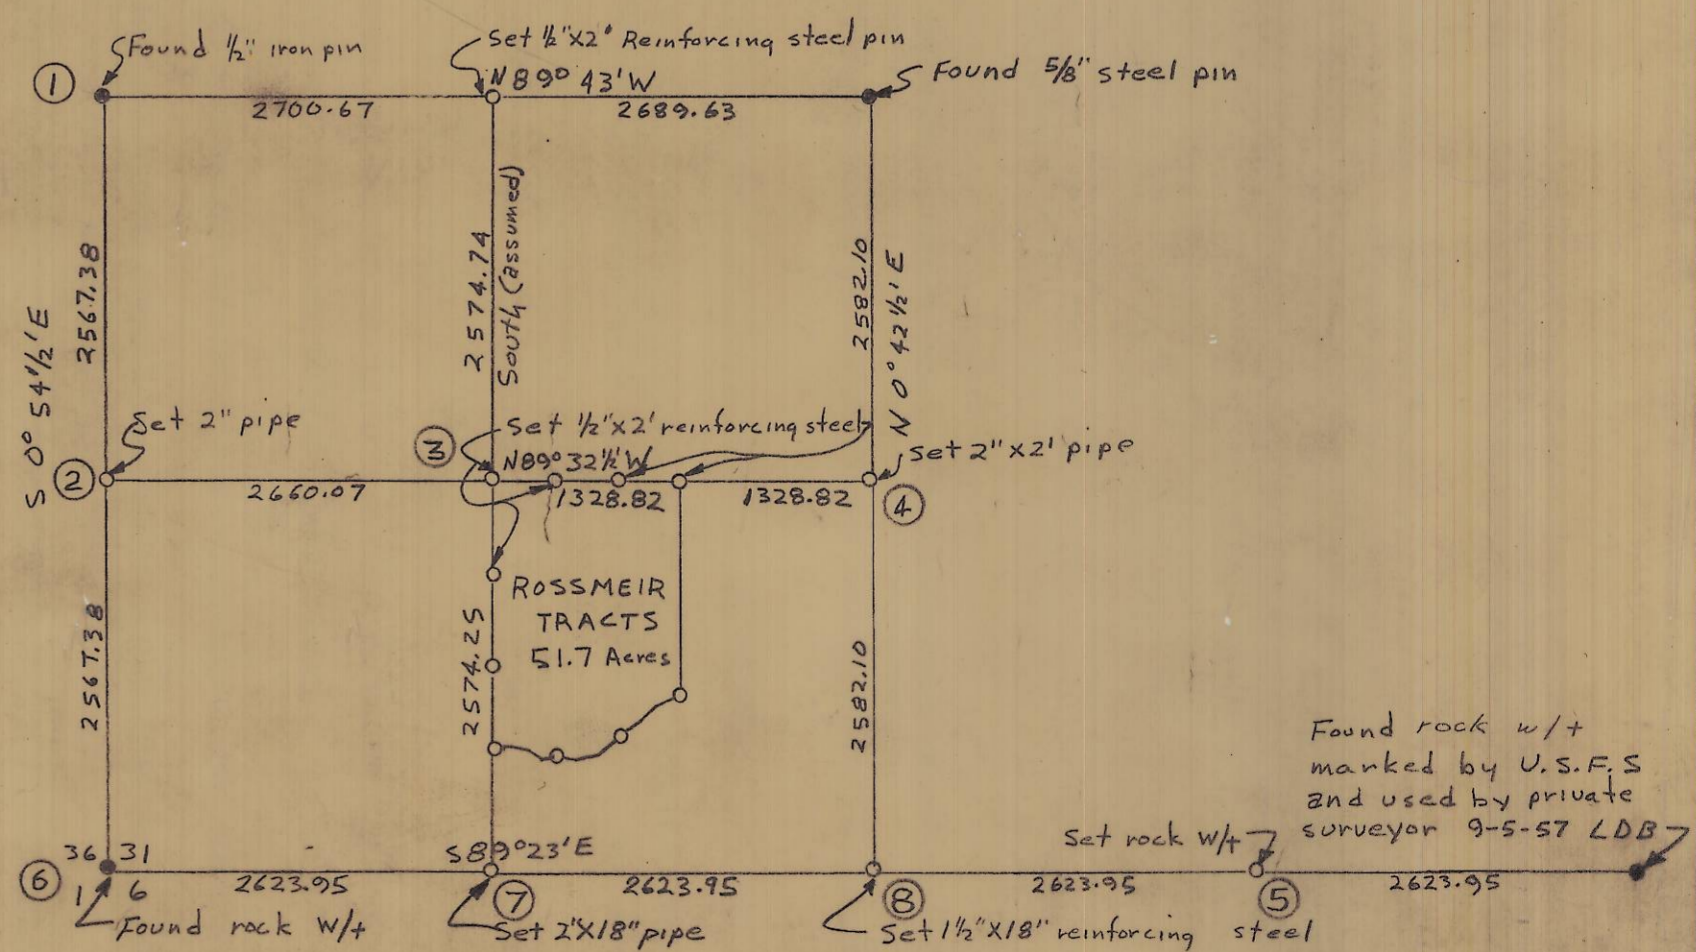

L-58-8