


RECORD OF SURVEY FOR UMATILLA ELECTRIC COOPERATIVE

OF A TRACT OF LAND IN
SECTION 9, T 2 N, R 33 E, W.M.
UMATILLA COUNTY, OREGON

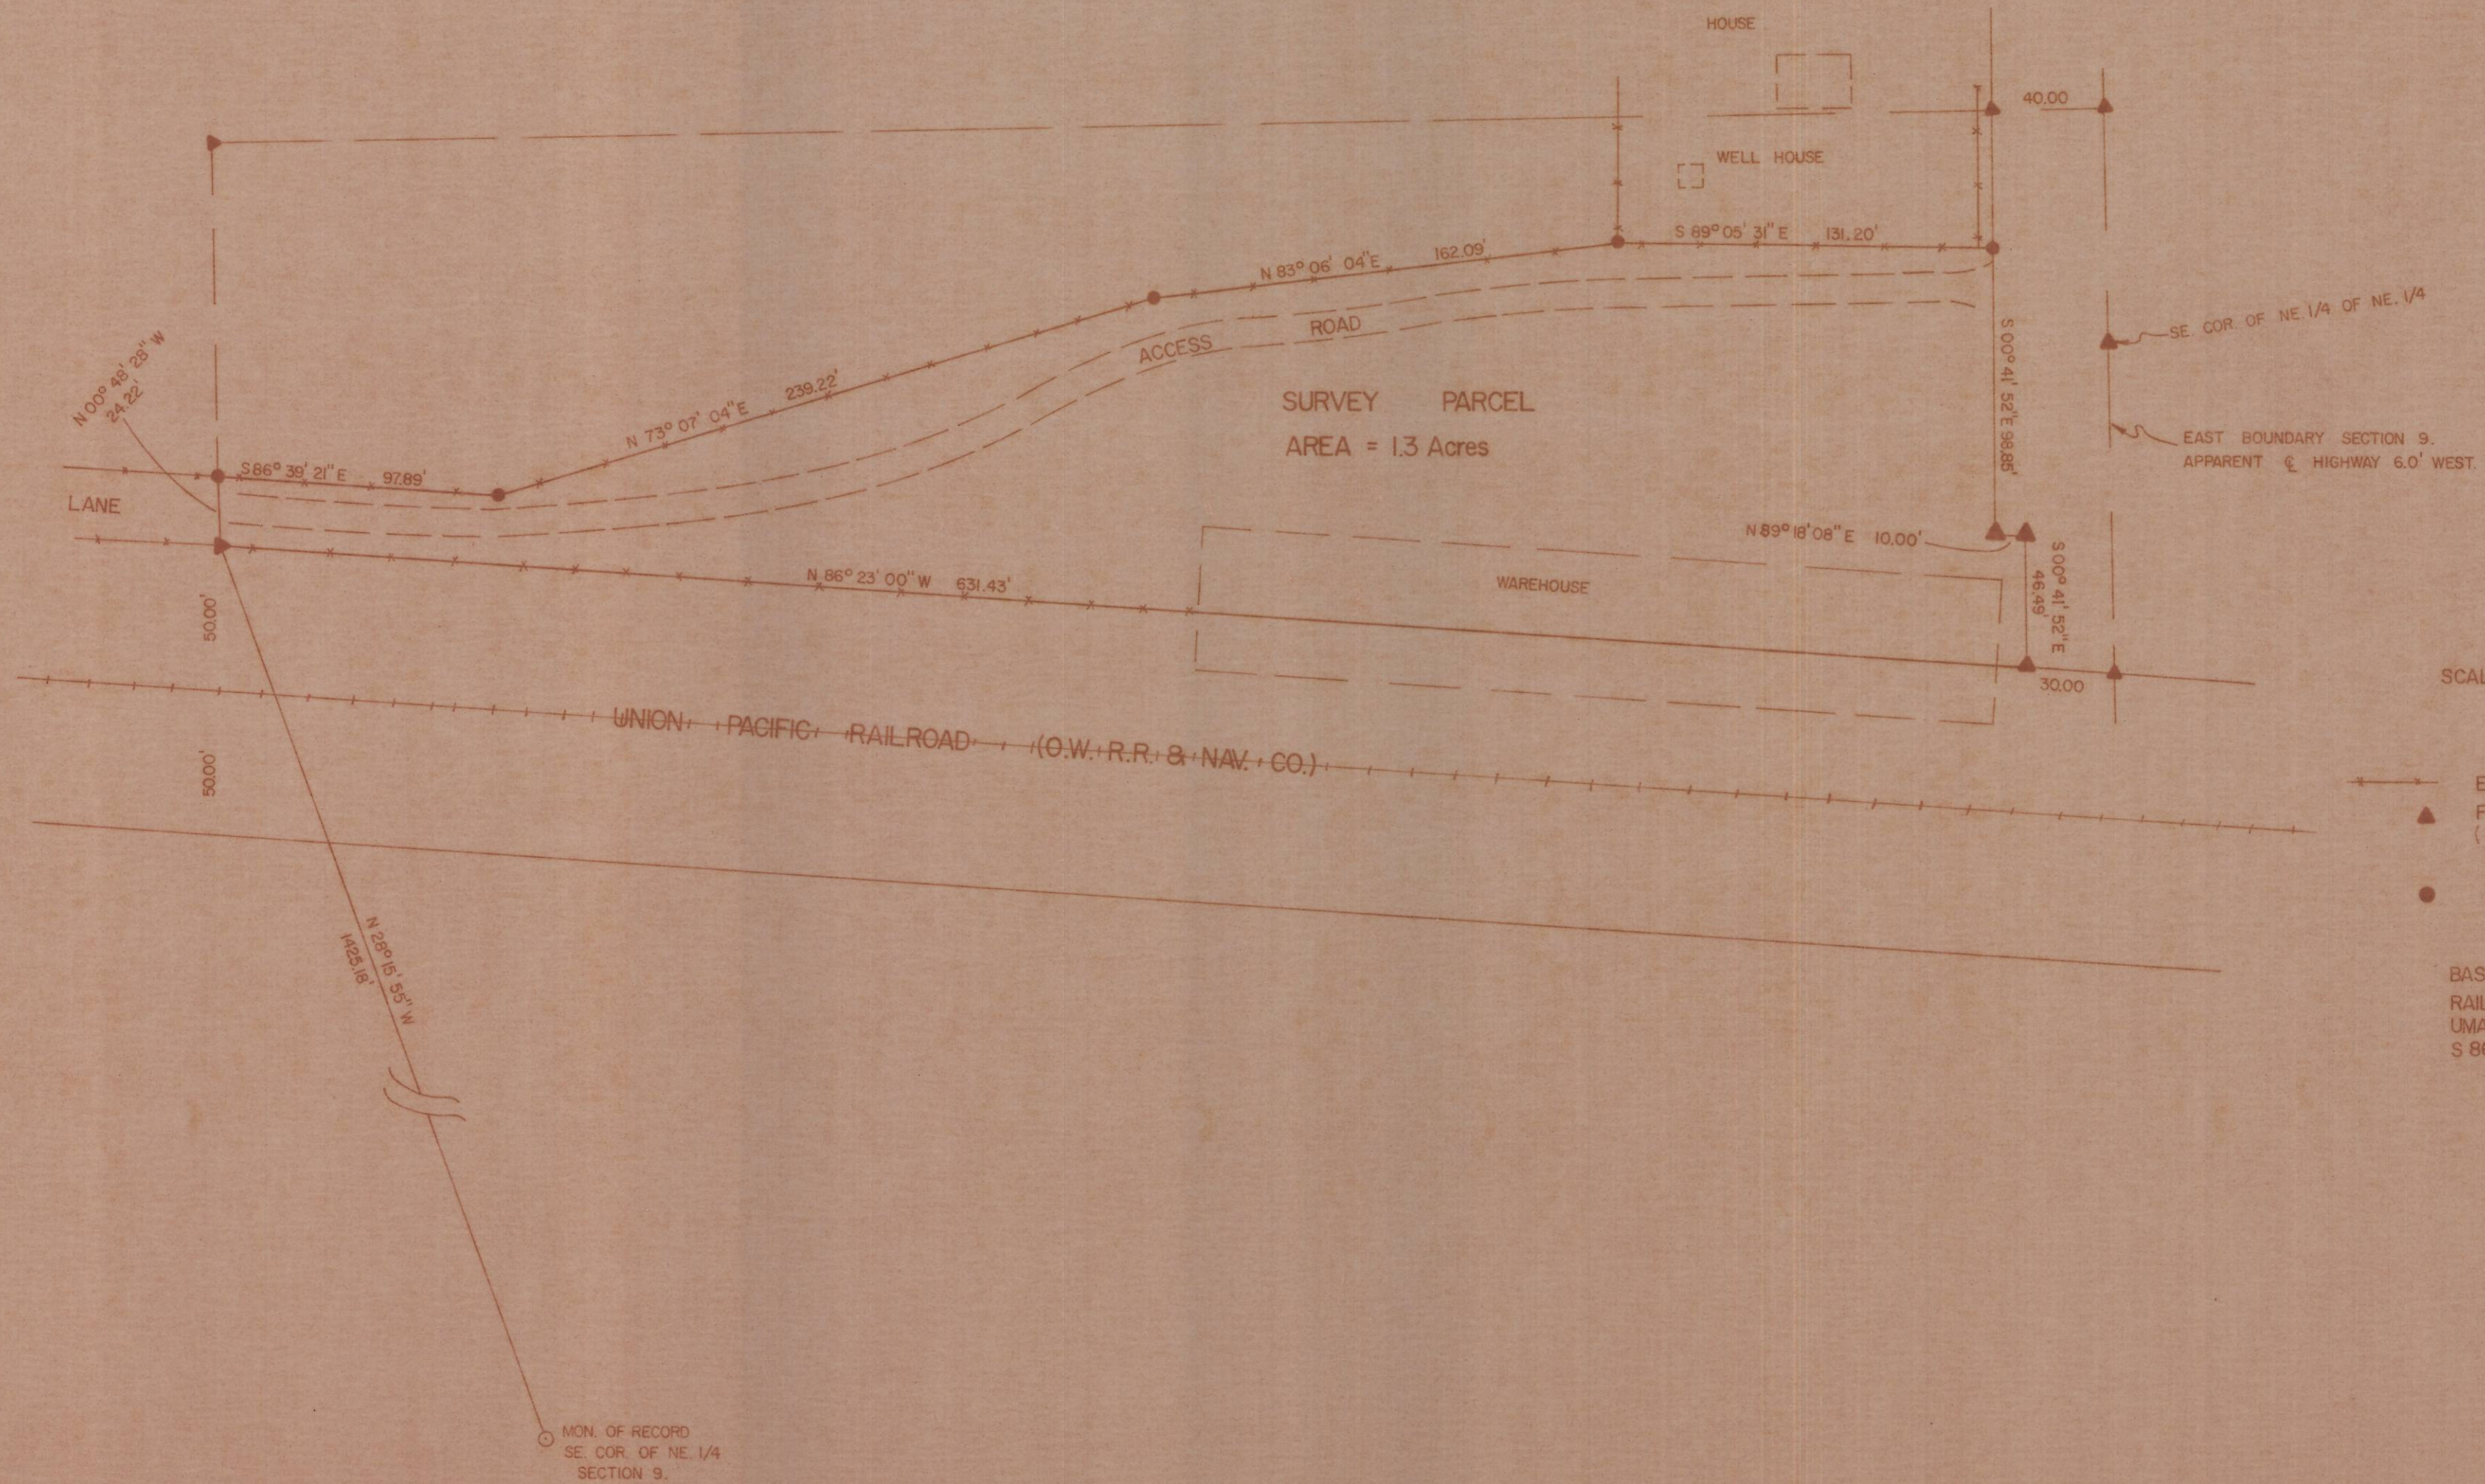

B-M49

RECORD OF SURVEY	
FEB. 1977	TELEK ENGINEERING 540 SW 11th HERMISTON, OREGON 97838