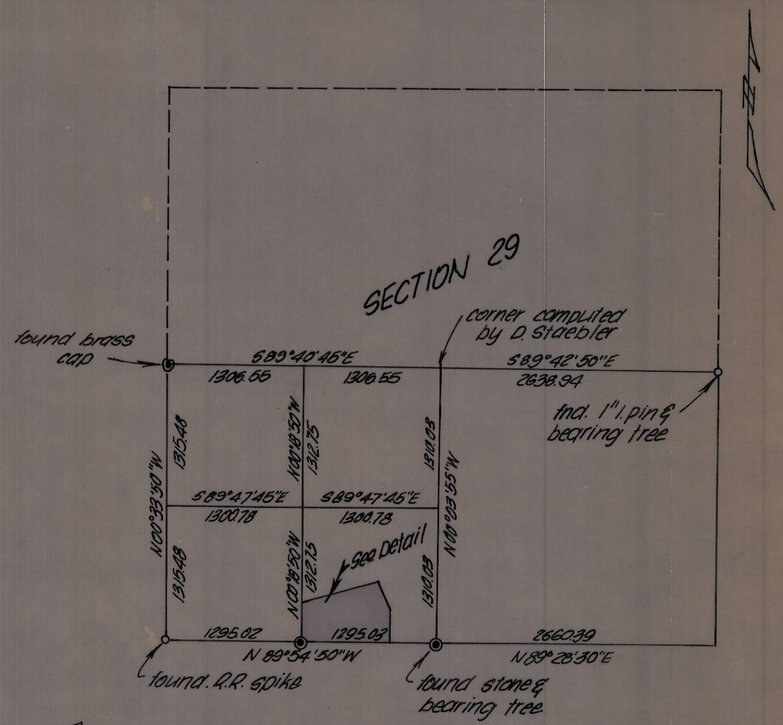

SECTION BREAKDOWN
1"=1000'

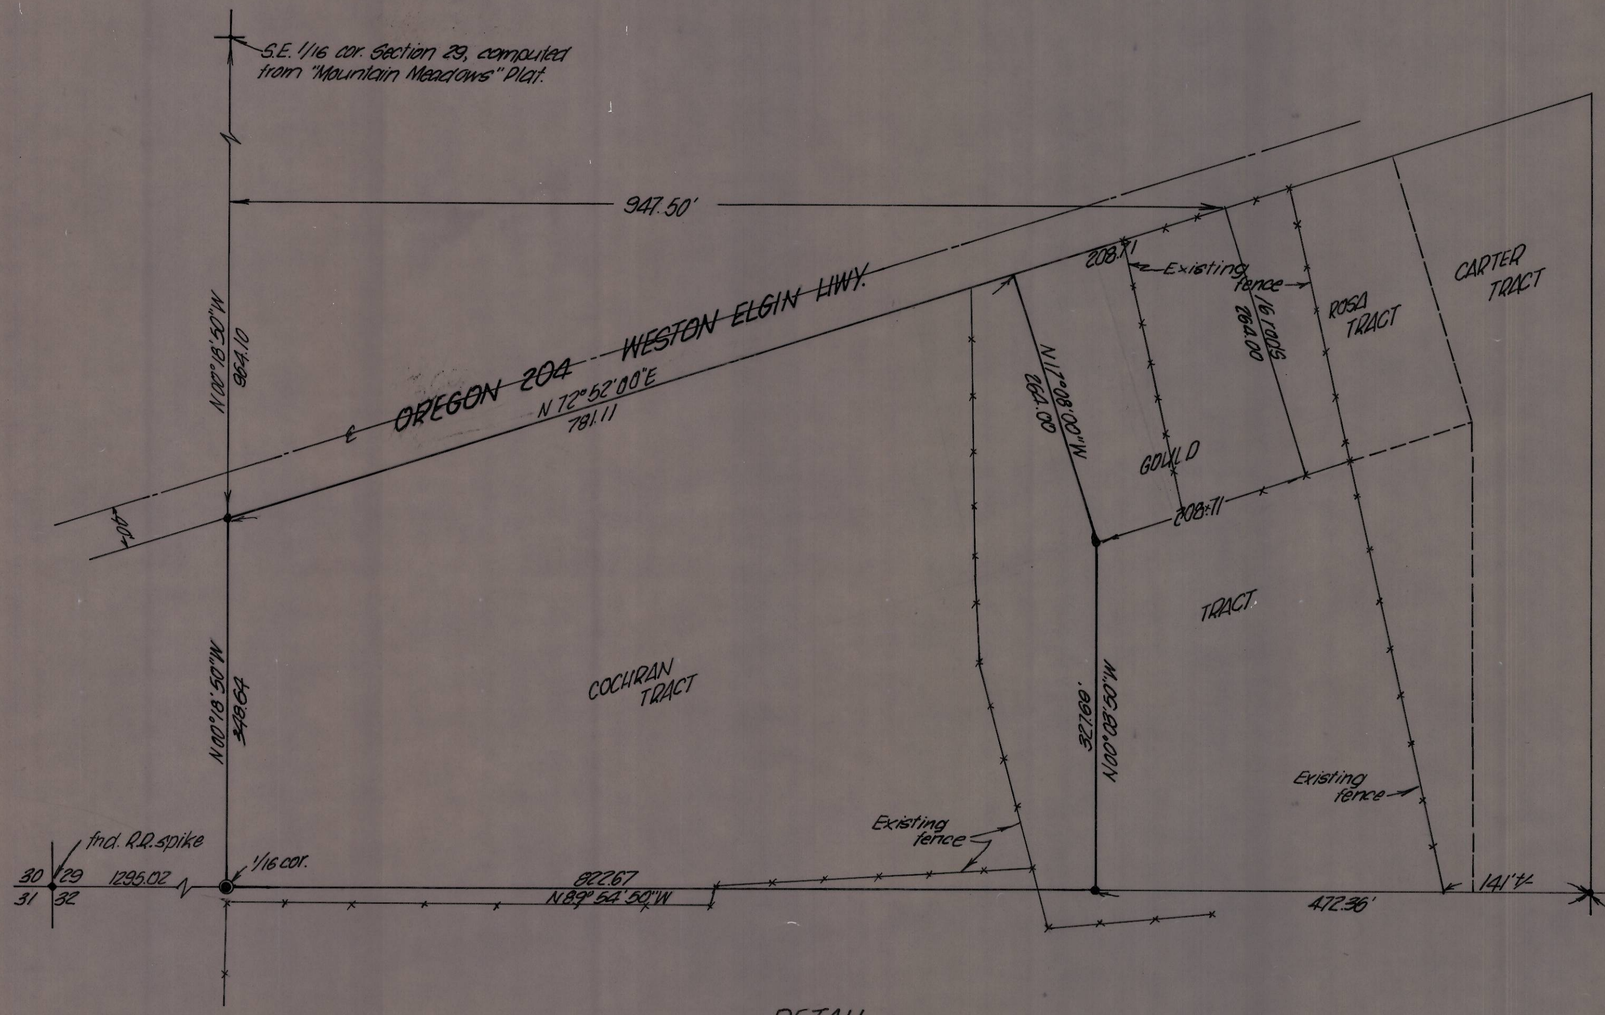

DETAIL
1"=100'

LEGEND:

- ● - set 5/8 in. pin
- ◉ - set brass cap

NOTE:

Bearings based on "MOUNTAIN MEADOWS" addition. All distances shown are true.
See Krumbein Engineering drawing number 76-82C

REGISTERED PROFESSIONAL LAND SURVEYOR
OREGON
JULY 17, 1962
DAVID H. KRUMBEIN
933

KRUMBEIN ENGINEERING CO
ENGINEERS - SURVEYORS - PLANNERS
221 S. Main, Pendleton, Oregon

Survey for
CLAIR COCHRAN
Parcel in the S.E. 1/4, S.W. 1/4
Section 29, T.4N., R.31E., W.M.

	1"=100'
	May 17, 1977
	P.L.S.
	J.L.C.
	77-25C

W-73-B