REGISTERED PROFESSIONAL LAND SURVEYOR
G. Dennis Edwards
OREGON
JULY 16, 1971
G. DENNIS EDWARDS
951

SURVEY FOR AL CONFORTH

LOCATION SW 1/4

SEC. 23, T 5 N, R 28 E, W.M., UMATILLA COUNTY, OREGON

DATE 3-14-78

SCALE: 1" = 600'
1" = 300'

● MONUMENTS FOUND

(000) OF RECORD

o IRON RODS SET 1/2"

JOB NO. S7801006

EDWARDS SURVEYING
567-3336

P. O. Box 763
Hermiston, Ore.

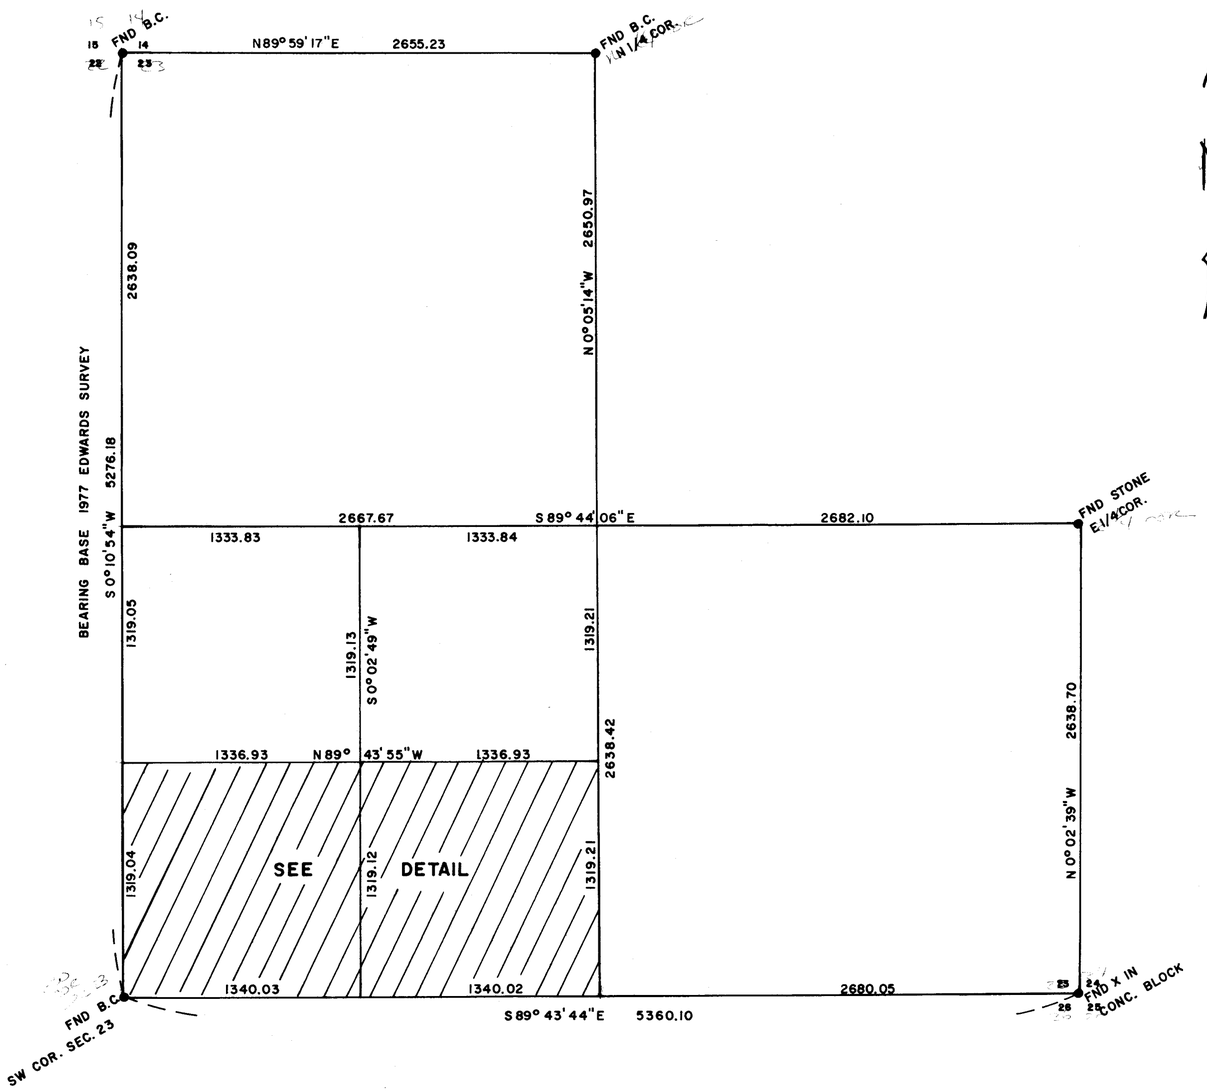

SCALE 1" = 600'

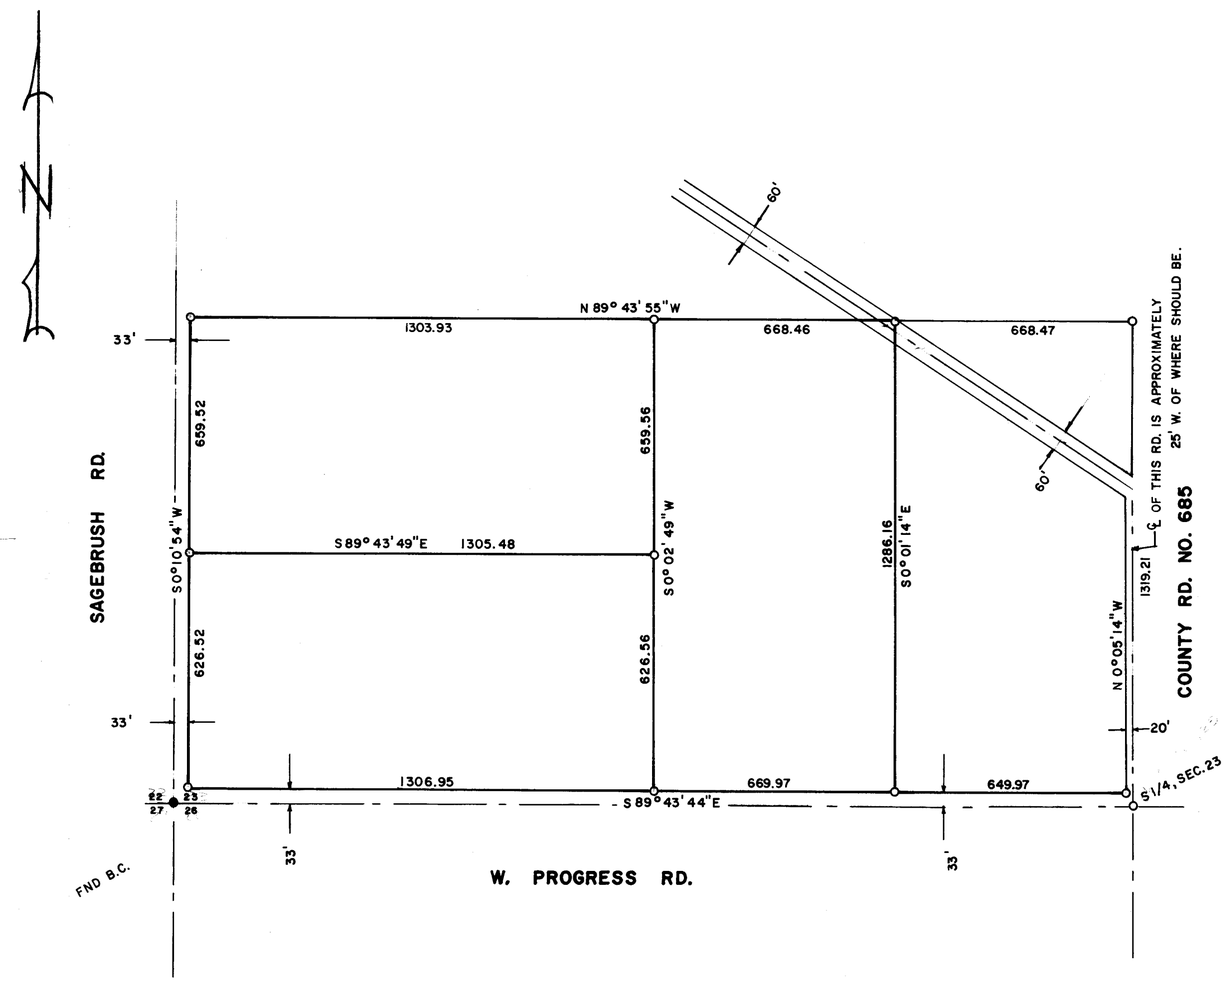

DETAIL
SCALE 1" = 300'

O-012-B

S7801006