

CURVE NUMBER	RADIUS	ARC	CHORD	CHORD BEARING
1	72.30	61.33	59.51	N 12° 18' 28" W
2	603.00	420.62	412.15	N 7° 59' 14" W
3	686.30	205.83	205.05	N 19° 22' 44" W
4	2895.00	13.38	13.38	N 10° 55' 10" W


Found Section Cor.
1/2" Sq. Rod Set
in Concrete

Found Conc. Monument

Notes:

Found pin was set by Wallulis & Associates
for E.S. Schnell dated 7/1/77.

- denotes found 5/8 in iron pin

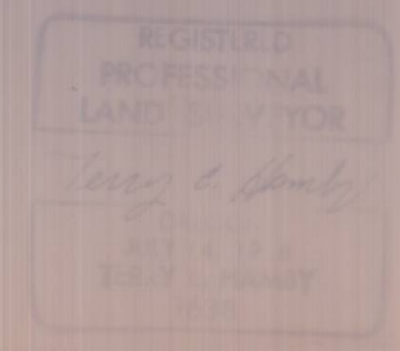

KRUMBEIN ENGINEERING CO.
ENGINEERS - SURVEYORS - PLANNERS
221 S. Main, Pendleton, Oregon

Survey for
GARY JELLUM
S E 1/4 Sec. 5 & SW 1/4 Sec 4, T2N R6 E S32E
Job No 78-288

1" = 100'
Dec. 15, 1978
DRAWN BY
CHKD BY
DATE NO

by Terry Hamby
PLS 1638

Q-4
B